


SCALE 1"=100'  
 Basis of Bearings R.S. No 3244

**LEGEND**

- = Set 5/8" x 18" I. Pin w/plastic cap mkd. "Burrell RLS 638"
- = Found 5/8" Iron Pin per R.S. No. 3244
- ⊙ = Found 5/8" Iron Pin per R.S. No. 7455
- D.R. = Deed Record or Deed Records of Jackson County
- O.R. = Official Records of Jackson County
- J.V. = Journal Voucher (on file with Jackson County Planning)

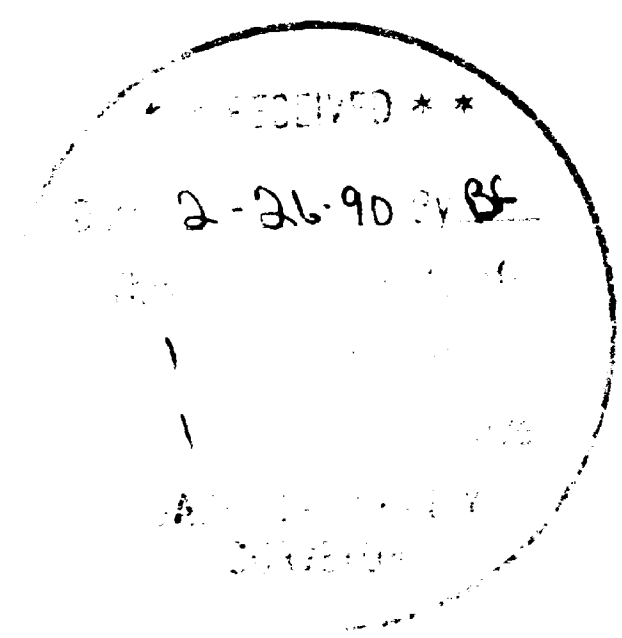

REGISTERED  
 PROFESSIONAL  
 LAND SURVEYOR  
*George Burrell*  
 OREGON  
 JULY 10, 1964  
 GEORGE R. BURRELL  
 638

**MAP OF SURVEY**  
 LOCATED IN S.W. 1/4 SECTION 6, T36S, R1W  
 FOR: V. JOHN KILEJIAN, M.D.  
 BY: George Burrell, R.P.L.S., 1379 Brookdale  
 Medford, Oregon 97504, Jan. 18, 1990

SURVEY NARRATIVE TO COMPLY WITH O.R.S. 209.250

FOR:

John Kilejian, M.D.  
10772 Modoc Road  
White City, OR 97503

LOCATION:

The S.W. 1/4 of Section 6, Twp. 36 South, Range 1 West

PURPOSE:

To monument the Southerly boundary of Tax Lot No. 701-36-1W-6 as described in J.V. 79-01047 on file with the Jackson County Dept. of Planning. Also, to monument and describe the lot line adjustment affecting the Northerly boundary of said tax lot as shown on the accompanying map.

PROCEDURE:

The Southerly boundary was established at record distance (200.00 feet) Southerly from the found 5/8" iron pin set by R.S. No. 3244 and record distance (49.00 feet) Northerly from the found 5/8" iron pin set by R.S. No. 7455.

The adjusted Northerly boundary was monumented and described according to the approved lot line application and the clients instructions.

BY:

George Burrell, R.P.L.S.  
1379 Brookdale  
Medford, Oregon 97504 Jan. 18, 1990

T.L. No. 701-36-1W-6

