

Survey No. 1192

Survey Narrative to comply with O.R.S. 209-205 and C.R.S. 209-120

Survey for: Joe Headlee

Survey by: Edward A. McGinty 12/30/58



PRECEDENCE OF SURVEY:

Found the northwest corner of Lot 1, being a $1\frac{1}{2}$ inch gal. pipe, approximately 8 inches deep.

Found the southwest corner of Lot 6, being a $3/4$ inch pipe, approximately 6 inches deep.

Found the southwest corner of Lot 8, being a $3/4$ inch pipe, slightly bent.

Measured North from the southwest corner of Lot 6, to the northwest corner of Lot 1, and at proportional distance, set a $5/8$ inch iron pin, 1 foot southerly from the corner. From the corner measured easterly, 35.81 feet. Found an old $1/2$ inch iron pin at old fence intersection. Found angle $91^{\circ} 10'$ of the west line, varies considerably from record angle. This old iron pin is unquestionably intended to be the original northeast corner of Lot 6, as measuring North and to the south corners, falls at fence corners.

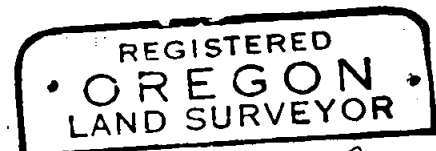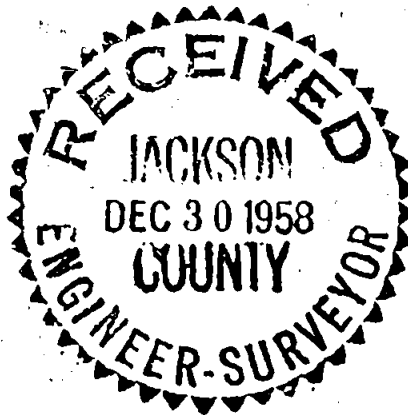

Edward A. McGinty

