


PLAT OF SURVEY

LOCATED in the NW 1/4 of Section 29, T. 38 S., R. 2 W., W.M. in Jackson County, Oregon.

February 23, 1990


SURVEYED FOR: *Boise Cascade Timber & Wood Products Group*
 P.O. Box 100
 Medford, Oregon 97501

SURVEYED BY: *Edwards Surveying and Land Planning Inc.*
 1014 East Pine Street
 Central Point, Oregon 97502
 Phone: (503) 664-1539

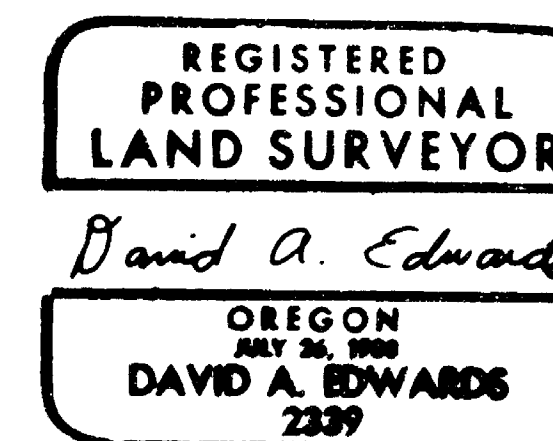

LEGEND

- Indicates monument found as noted.
- Indicates 5/8" x 30" steel pin w/plastic cap mkd. "D.A. EDWARDS-RPLS 2339" set.
- () Denotes record data as noted.
- x—x—x Fence line
- R.S.N. = Recorded Survey Number
- J.C.S. = Jackson County Surveyor
- SCALE: 1" = 400'
- BASIS OF BEARINGS: South line, SW 1/4 of NW 1/4, Section 29, per R.S.N. 8882.
- Indicates property boundary blazed and tagged this survey.

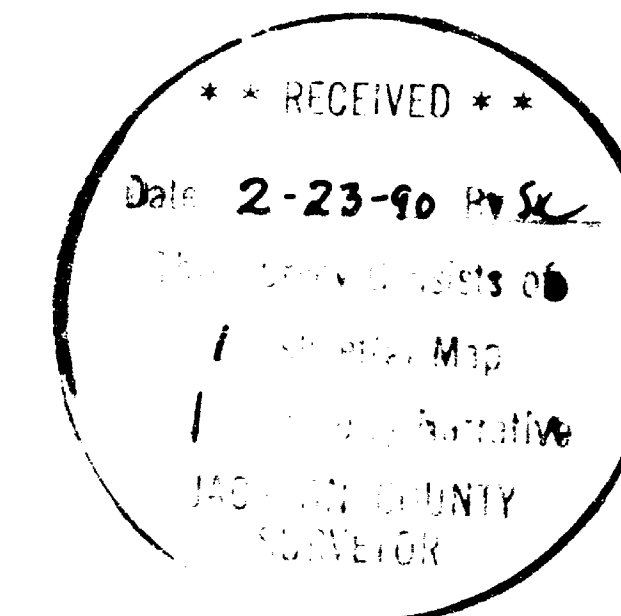

SURVEY NUMBER 11923

Edwards Surveying and Land Planning Inc.
Registered Land Surveyors
1014 East Pine St.
Central Point, Oregon 97502
(503)664-1539

SURVEY NARRATIVE TO COMPLY WITH CHAPTER 209, PARAGRAPH 250,
OREGON REVISED STATUTES

SURVEY FOR: Boise Cascade Timber and Wood Products Group
P.O. Box 100
Medford, Oregon 97501

LOCATION: In the NW 1/4 of Section 29, T. 38 S., R. 2 W.,
W.M. in Jackson County, Oregon.

PURPOSE: To locate and monument two 1/16 corners in
Section 29 and to mark property boundaries by
blazing trees and setting metal tags along said
boundaries as shown on the accompanying plat.

PROCEDURE: A closed loop control traverse was executed
which closed about 1:25,000. This loop was then
balanced and adjusted. From points in this
control loop, two short side traverses were run
to tie in the NW corner and North 1/4 corner
of Section 29. Record data per Recorded Survey
Number 8882 was utilized to establish a
proportionate position for the South 1/4
corner. Closed traverses were run along the
desired boundaries, closing about 1:10,000.
Traverse points were then adjusted to true line
and the lines blazed and tagged. Monuments set
on this survey consist of 5/8" x 30" steel pins
with red plastic caps mkd. "D.A. EDWARDS-RPLS
2339". Bearing trees were marked according to
the 1973 B.L.M. Manual, measured to the center
of tree at root crown, and are situated as
follows:


At the North 1/16 corner to Secs. 29 and 30:
A 5" diam. W. Oak bears N. 28° E., 14.52 ft.
A 5" diam. Fir bears S. 13° W., 21.51 ft.

At the CN 1/16 corner in Section 29:
An 8" diam. Fir bears N. 15° E., 19.89 ft.
A 6" diam. Fir bears S. 47° E., 32.82 ft.

BASIS OF BEARINGS: South line, SW 1/4 of NW 1/4 Section 29, per
R.S.N. 8882.

EQUIPMENT: Nikon NTD-4 Semi-automatic theodolite/E.D.M.

DATE COMPLETED: February 23, 1990.

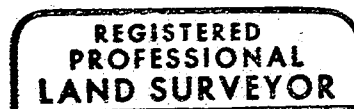

David A. Edwards

