

REGISTERED
PROFESSIONAL
SURVEYOR
LARRY J. FRIAR
OREGON
JULY 16, 1971
LARRY J. FRIAR
961

MAP OF SURVEY
FOR
FRANK BALL JR.

LOCATED IN THE S.E. 1/4 OF SECTION 29, T.34 S., R. 2 W.,
W.M., JACKSON COUNTY, OREGON.
DATE: MARCH 2, 1990 SCALE: 1" = 100'
SURVEYED BY: L. J. FRIAR & ASSOCIATES
717 WEST TENTH ST.
MEDFORD, OREGON

3-14-90
JACKSON COUNTY
SURVEYOR

T.34 S., R. 2 W., S 29 T.L. 1800

Survey No. 11941

Survey Narrative To Comply With O.R.S. 209.250

Survey For: Frank Ball Jr.
1316 N. 9th St.
Philomath, OR. 97370

Location: S. E. 1/4 Section 29, T. 34 S.R2W .M.
Jackson County , OR.


Purpose: To Monument a Lot Line Adjustment File
89-38 LLA .

Procedure: Surveyed and Monumented the Line as shown
on the annexed Map utilizing previous Survey
No.9207 by this office.

Basis of Bearing: Survey No. 8087

Date: March 13, 1990.

T.34 S., R.2 W., SEC. 29 TL 1800 & 1801

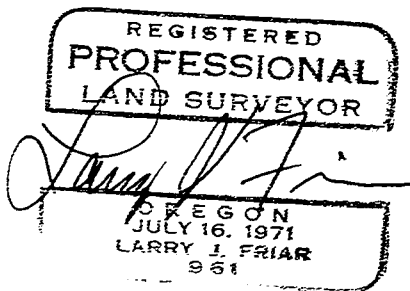

Larry J. Friar
L.J. Friar & Associates P.C.
Consulting Land Surveyors
717 West 10th, Suite 1
Medford, OR 97501
(503) 772-2782

