

LEGEND

- FD. JACKSON COUNTY BRASS CAP PER 1985 RE-ESTABLISHMENT
 - ⊙ FD. B.L.M. BRASS CAP PER 1986 B.L.M. CADASTRAL SURVEY
 - ⊙ FD. 5/8" RE-BAR W/ YELLOW PLASTIC CAP MKD. " NYGREN RS 1035 " PER R.S. NO. 10470
 - SET 5/8" x 30" REBAR WITH YELLOW PLASTIC CAP MARKED " TEMPLIN 2359"
 - () RECORD BEARING /DISTANCE PER 1986 B.L.M. CADASTRAL SURVEY
 - [] RECORD BEARING /DISTANCE PER RECORDED SURVEY NO. 10470
 - TRUE LINE BLAZED AND PAINTED RED
- BEARINGS BASED UPON THE SOUTH LINE OF SECTION 3 PER RECORDED SURVEY NO. 10470

*** RECEIVED ***
 Date 3-15-90 By SK
 This survey consists of
1 sheet(s) Map
2 page(s) Narrative
 JACKSON COUNTY
 SURVEYOR

RICHARD TEMPLIN LAND SURVEYING
 2042 SANDRA PL 776-0991 MEDFORD, OREGON

PLAT OF SURVEY
 LOCATED IN
 SECTIONS 3 & 10, T.34S., R.4W., W.M.
 JACKSON COUNTY, OREGON

SURVEY FOR: BOISE CASCADE CORP. DATE: MARCH, 1990
 P.O. BOX 100
 MEDFORD, OREGON

REGISTERED
 PROFESSIONAL
 LAND SURVEYOR

R. G. Templin

OREGON
 JULY 24, 1988
 RICHARD G. TEMPLIN
 2359

11944

RICHARD G. TEMPLIN
PROFESSIONAL LAND SURVEYOR

2042 Sandra Pl.
Medford, Oregon 97504
(503) 776-0991 • 474-7720

I then run on true line S 89°37'24" E, 1308.75 feet to the SE 1/16 corner which I set:

A 5/8"x 30" Rebar, with a yellow plastic cap marked "TEMPLIN 2359", from which I scribe the following bearing trees:

A Ponderosa Pine, 8" diameter bears N 86°E, 11.0 feet, scribed "SE1/16S3" "BT".
A Ponderosa Pine, 13" diameter bears N 4° W, 13.8 feet, scribed "SE1/16S3" "BT".


From the E 1/16 corner, I ran true line N 00°32'42" W, 1334.28 feet to the SE 1/16 corner to close.

I also ran from the E 1/16 corner of Section 3 to the NE 1/16 corner of Section 10 as shown on the plat.

At the C 1/4 corner of Section 3 I set:

A 5/8"x 30" Rebar, with a yellow plastic cap marked "TEMPLIN 2359", from which I scribe the following bearing trees:

A Madrone, 8" diameter bears North, 11.3 feet, scribed "C1/4S3" "BT".
A Douglas Fir, 6" diameter bears N 40° E, 14.7 feet, scribed "C1/4S3" "BT".
A Live Oak, 8" diameter bears N 23° W, 27.3 feet, scribed "C1/4S3" "BT".
A Cedar, 4" diameter bears N 7° W, 29.1 feet, scribed "C1/4S3" "BT".
Corner falls in burn area, approximately 50 feet North of gravel road c.N 50°W and South, 75 feet from saddle on top of ridge c.East-West.

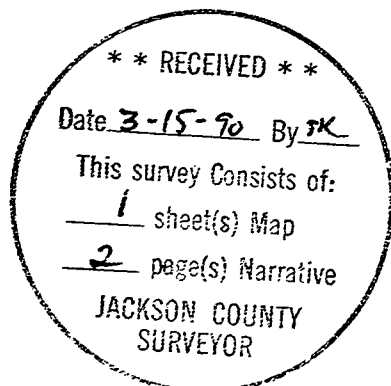

RICHARD G. TEMPLIN
PROFESSIONAL LAND SURVEYOR
2042 Sandra Pl.
Medford, Oregon 97504
(503) 776-0991 • 474-7720

SURVEY NO. 11944

SURVEY FOR: Boise Cascade Corp.
P.O. Box 100
Medford, Oregon 97501

Location: Sections 3 & 10 Township 34 South, Range 4
West, Willamette Meridian, Jackson County,
Oregon.

Purpose: To monument the SW 1/16, CS 1/16 and the SE
1/16 corners of Section 3, also set the C 1/4
of Section 3. Then to mark true line as shown
on accompanying plat.

Date: March, 1990

**Basis of
Bearing:** Based upon the South line of Section 3 per
Recorded Survey number 10470.

Procedure: Utilizing a Wild T-2, Wild T-16 and Mac 1E
EDM and Red 2L EDM, tied North, East, South
and West Quarter Corners, W 1/16 and E 1/16
corners of Section 3.
Computed and ran true line N 00°06'41" E from
the W 1/16 corner, 1319.03 feet to the SW 1/16
corner which I set:

A 5/8"x 30" Rebar, with a yellow plastic cap
marked "TEMPLIN 2359", from which I scribe the
following bearing trees:

A Cedar, 4" diameter bears S 51° W, 15.0 feet,
scribed "SW1/16S3" "BT".
A Ponderosa Pine, 4" diameter bears S 29° W,
24.0 feet, scribed "SW1/16S3" "BT".

I then run on true line S 88°26'12" E, 1318.71
feet to the CS 1/16 corner which I set:

A 5/8"x 30" Rebar, with a yellow plastic cap
marked "TEMPLIN 2359", from which I scribe the
following bearing trees:

A Black Oak, 6" diameter bears S 37°W, 5.50
feet, scribed "CS1/16S3" "BT".
A Douglas Fir, 6" diameter bears N 13°W, 3.30
feet, scribed "CS1/16S3" "BT".