


12002

7 9  
FD. 1 1/4" IRON PIPE PER  
R.S. NO. 5041

### SURVEY FOR LOT LINE ADJUSTMENT

LOCATED IN  
WEST 1/2 OF SECTION 8, T.38S.,R.2W.,W.M.,JACKSON COUNTY, OREGON

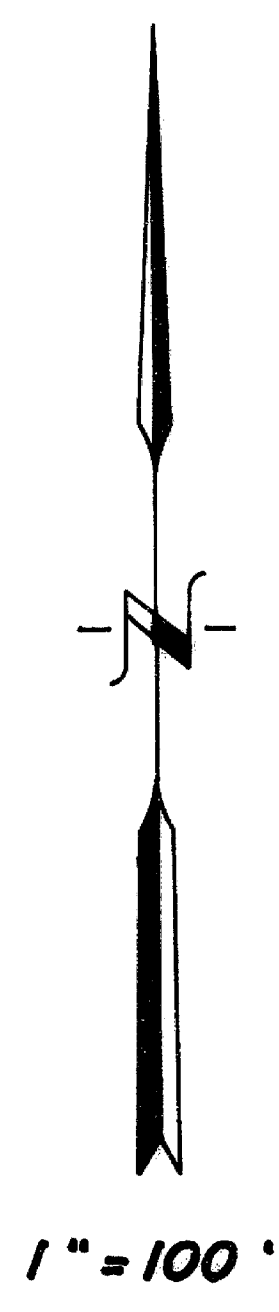

1" = 100'

(S 00° 07' 20" E 823.02')

N 89° 52' 40" E 431.29

20.0' WIDE ROAD  
EASEMENT

20'

N 00° 07' 20" W 505.00

5.00 ± ACRES

ORIGINAL LOT LINE

S 00° 07' 20" E 505.00

S 89° 52' 40" W 431.29

**SURVEY FOR :** PATRICIA MADDOX  
280 POORMAN CR. RD.  
JACKSONVILLE, OREGON

**SURVEY BY :** RICHARD TEMPLIN LAND SURVEYING  
2042 SANDRA PL.  
MEDFORD, OREGON  
776-0991

**DATE :** APRIL 28, 1990

- FD. 5/8" IRON ROD PER R.S. NO. 5041
- SET 5/8" IRON REBAR WITH YELLOW PLASTIC CAP MKD " TEMPLIN 2359 "
- ( ) RECORD PER R.S.NO. 5041

BEARINGS BASED UPON RECORDED SURVEY NO. 5041.

\*\* RECEIVED \*\*  
Date 4-30-90 by RS  
This survey consists of:  
1 sheet(s) Map  
1 page(s) Narrative  
JACKSON COUNTY  
SURVEYOR

REGISTERED  
PROFESSIONAL  
LAND SURVEYOR  
*M G Templin*  
OREGON  
JULY 26, 1988  
RICHARD G. TEMPLIN  
2359

38-2W-6-TL 202

12002

**RICHARD G. TEMPLIN**  
PROFESSIONAL LAND SURVEYOR  
2042 Sandra Pl.  
Medford, Oregon 97504  
(503) 776-0991 • 474-7720

SURVEY NO. 12002

**SURVEY FOR:** Patricia Maddox  
280 Poorman Cr. Rd.  
Jacksonville, Oregon

**LOCATION:** West 1/2 of Section 8, Township 38 South,  
Range 2 West, Willamette Meridian, Jackson  
County, Oregon.

**PURPOSE:** To monument Tax Lot 202 per Approved Lot Line  
Adjustment, Jackson County File #90-13-LLA.

**DATE:** April 28, 1990

**BASIS OF  
BEARING:** Based upon Recorded Survey number 5041

**PROCEDURE:** Utilizing a Wild T-16 and Mac 1E EDM tied  
monuments found on Recorded Survey number  
5041. Calculated new lot corner positions  
and set as shown on accompanying plat along  
with the required legal descriptions.

