

12015

**PROPERTY LINE SURVEY**  
IN THE SE1/4, SECTION 3, T39S, R1W, W.M.  
APRIL, 1990 SCALE: 1" = 200'


C 1/4, Section 3 FOR  
Fd. 3/4" I.R. DOUGLAS COUNTY FOREST PRODUCTS

AA SURVEYING SERVICE, INC.  
P.O. Box 130  
2566 N. Stephens Street  
Roseburg, Oregon 97470  
Tel. (503) 672-2096

REGISTERED  
PROFESSIONAL  
LAND SURVEYOR

*Mark A. Heimbarger*

OREGON  
JULY 16, 1987  
MARK A. HEIMBURGER  
2287

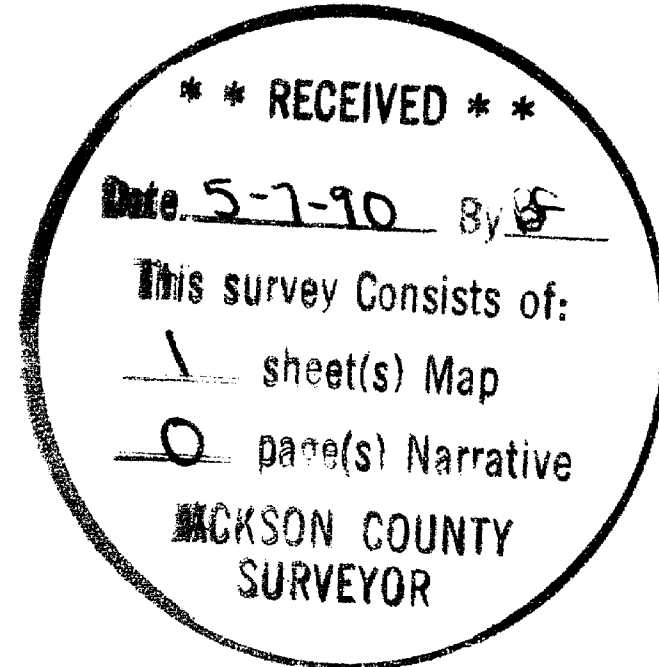

NARRATIVE

The purpose of this survey is to monument the Northwest corner of the South 880 feet of the Southwest 1/4 of the Southeast 1/4 of Section 3, Township 39 South, Range 1 West, Willamette Meridian.

The 1/4 Corner common to Section 3 and Section 10 and the Center 1/4 of Section 3 were found as shown on Survey Number 8401 as recorded with the Jackson County Surveyor's Office. These monuments were used to establish the west line of the Southwest 1/4 of the Southeast 1/4 of Section 3. The corner in question was set at record distance (880.00 feet) per the Deed of that property shown on Tax Plat 39 1W, Lot 6000.



BASIS OF BEARINGS PER SURVEY No. 8401  
N 0° 49' 14" W 2631.65'

880.00'

1/4 Sec. 3  
Sec. 10 Fd. 1 1/2" I.P. w/  
2 1/2" Bronze Cap

Tax Plat 39 1W  
Lot 6000

12015