

RECORD of SURVEY


LOCATED IN: LOT 3, BLOCK 1, BRYANT ADDITION
in the NW 1/4, SEC. 25, T.37S, R.2W, WM., in the CITY
of MEDFORD, JACKSON COUNTY, OREGON.

JANUARY, 1990

SCALE: 1"=100'

SURVEYED FOR: HAYWOOD CONSTRUCTION

NORTH
BASIS OF BEARINGS
☉ SUMMIT AVENUE PER
SURVEY NO. 11631

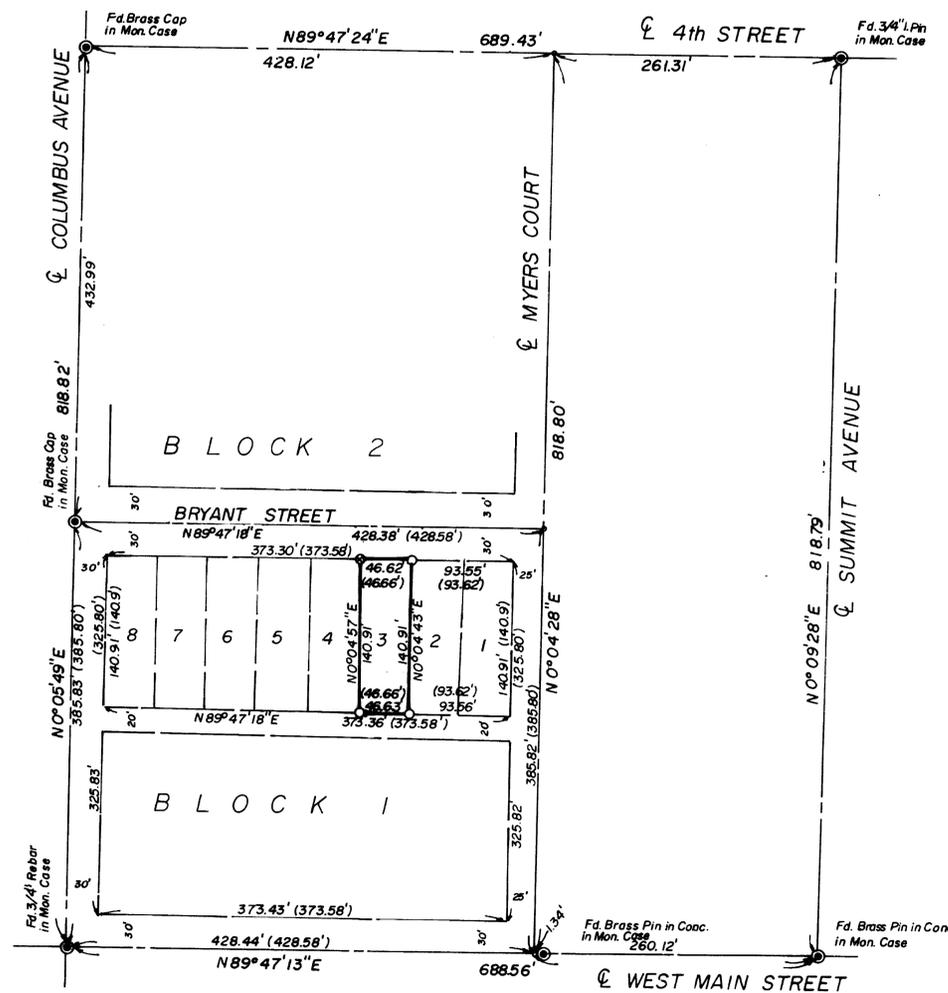


LEGEND

- ☉ = STREET ☉ MONUMENT FOUND AS SHOWN
- ⊕ = SET 5/8" x 24" REBAR WCAP MKD "ANDREWS PLS 1626"
- ⊗ = SET BRASS TAG & TACK IN LEAD IN SIDEWALK
- ⊙ = COMPUTED POSITION ONLY
- () = RECORD DATA PER PLAT

SURVEYED BY

JAMES ANDREWS
304 S. HOLLY
MEDFORD, OREGON, 97501
PH. 773-8866

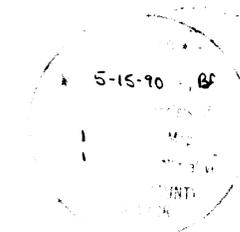

REGISTERED
PROFESSIONAL
LAND SURVEYOR

OREGON
JAMES E. ANDREWS
1028

SURVEY NO 12027

SURVEY NARRATIVE TO COMPLY WITH O.R.S. 209.250

DATE: January, 1990

SURVEYED FOR: Haywood Construction
P.O. Box 649
Selma, Oregon

LOCATION: Lot 3, Block 1, Bryant Addition in the North West
1/4 of Section 25, Township 37 South, Range 2
West, Willamette Meridian in the City of Medford,
Jackson County, Oregon

PURPOSE: To monument Lot 3

PROCEDURE: I located and tied the street centerline
monuments as shown. The centerline of Myers
Court was held per Survey No. 11631 and 2968. I
set the corners for Lot 3 per proportionate
measure.

BASIS OF BEARINGS: The basis of bearings is the centerline
of Summit Avenue per Survey No 11631.

SURVEYED BY: James Andrews
304 S. Holly
Medford, Oregon 97501

