

SURVEY NO. 12106

**CERTIFIED RECORD OF LAND CORNER MONUMENTATION
TO COMPLY WITH PARAGRAPH 209.130, O.R.S.**

History of original corner establishment:

The original corner point for the quarter corner, sections 9 and 16, Township 32 South , Range 4 East, Willamette Meridian, Jackson County, Oregon, was established by Rufus S. Moore under Contract No. 504 dated May 27, 1884. At the corner point, Moore set a 16" X 12" X 5" basalt stone and marked two fir bearing trees.

Description of corner evidence found:

At the corner point, I found an 18" X 12" X 2" basalt stone with 1/4 marked on the north face, and the following accessories:

A 43" diameter fir bears N.12°57'00"E., 26.50 feet distance, with bark scibe visible.

A 59" diameter fir bears S.46°21'00"E., 20.70 feet distance, with bark scribe 1/4S BT visible.


**Description of work accomplished to perpetuate
the original location of this corner:**

At the corner point, I remonumented the stone with a 2 1/2-inch diameter iron post with a 2 1/2-inch diameter brass cap attached and marked:

T 32 S R 4 E

S 9
1/4 —————
S 16
1990

LS 1071

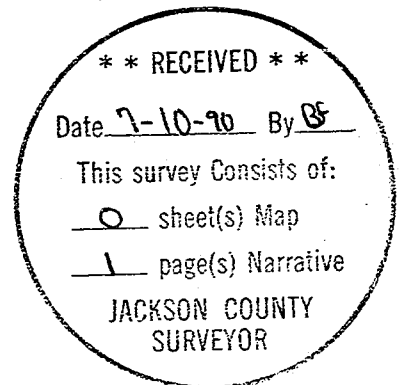

and mark the following accessories:

Below the bark scribe on the northeast bearing tree, now a 43" diameter fir, I scribe 1/4S9LS1071 BT.

A 5/8" diameter iron pin bears S.62°32'53"E., 244.39 feet distance, from which a second 5/8" diameter iron pin bears S.02°10'17"W., 405.36 feet distance. (these two points being the basis of bearing...solar observation points)

Basis of Bearing
Solar Observation

Date
June 26, 1990

HAROLD L. CENTER
REGISTERED PROFESSIONAL LAND SURVEYOR
OREGON CERTIFICATE NO. 1071

