

## MAP of SURVEY


located in

the Northwest Quarter of Section 14,
Township 39 South, Range 1 East of the
Willamette Base and Meridian,
JACKSON COUNTY OREGON

## LES SCHWAB TIRE CENTER, INC.

P.O. Box 667 Prineville, Oregon 97754

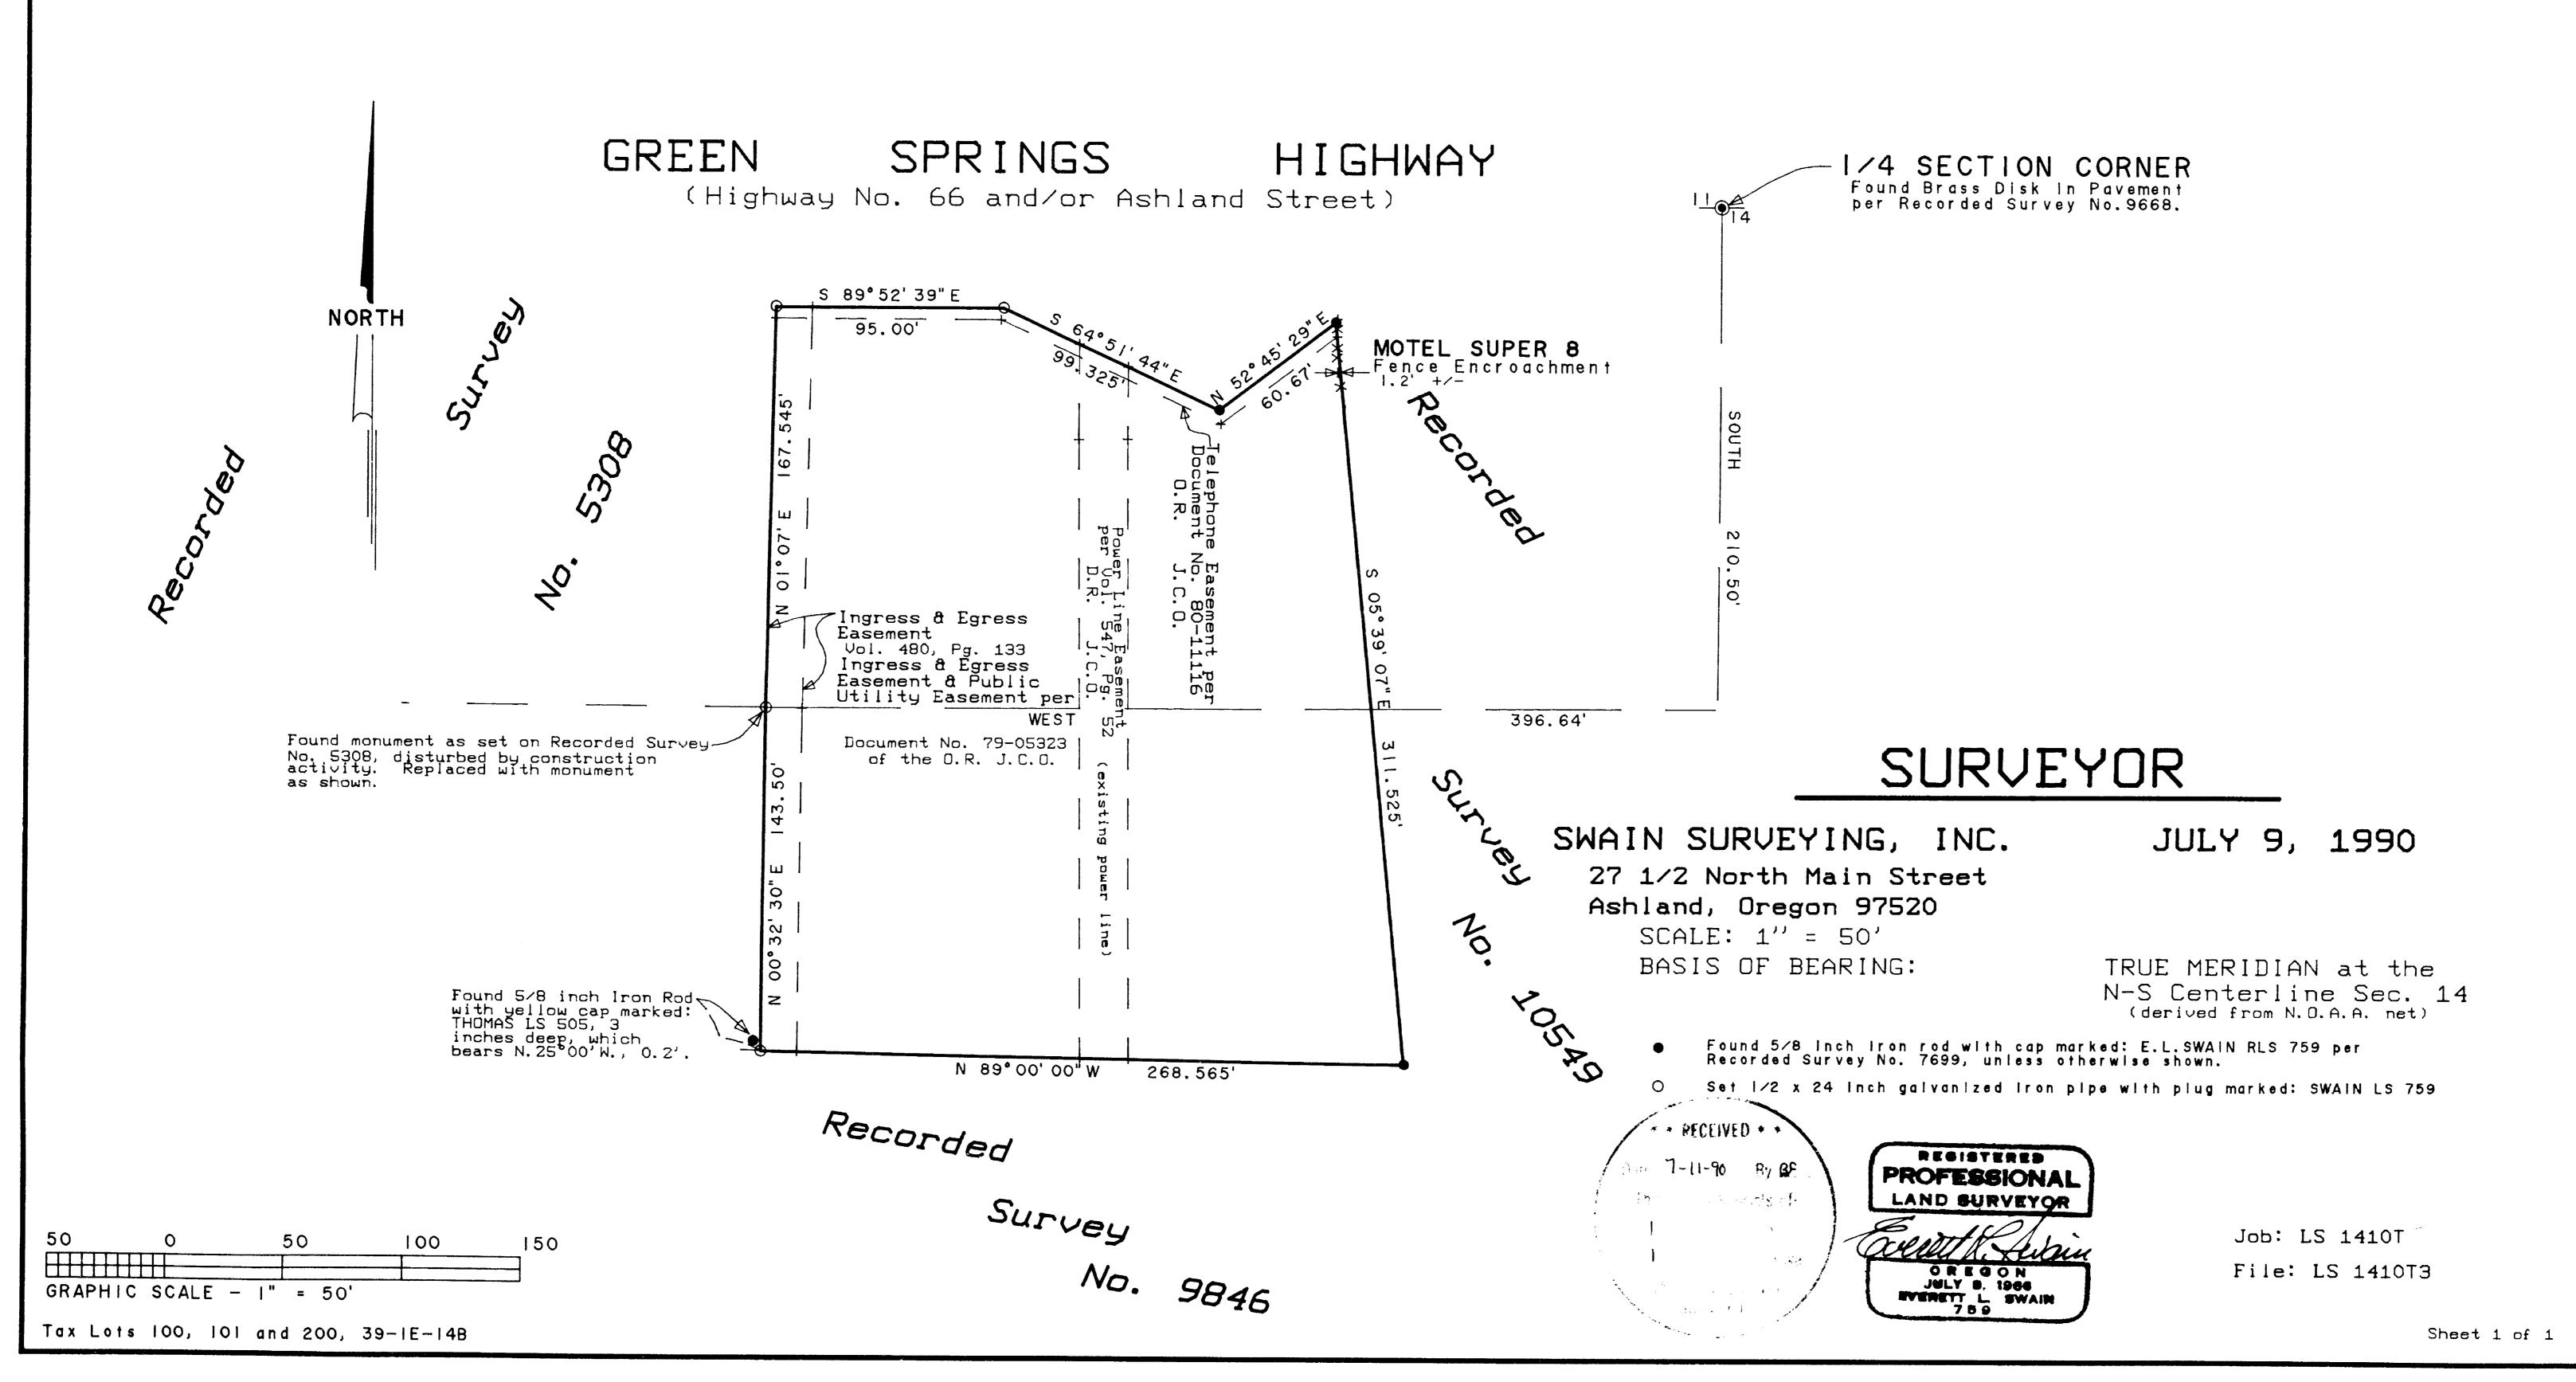

 

271/2 North Main Street Ashland, Oregon 97520

> 12110 Survey No.

SURVEY NARRATIVE TO COMPLY WITH PARAGRAPH 209.250 OREGON REVISED STATUTES

SURVEY FOR:

Les Schwab Tire Centers, Inc.

P.O. Box 667

Prineville, Oregon 97754

LOCATION:

Situated in the Northwest Quarter of Section 14, Township 39 South Range 1 East of the Willamette Base

and Meridian, Jackson County, Oregon.

PURPOSE:

To re-establish those corner monuments where disturbed or destroyed, as set and shown on Recorded Survey No.7699, on filed in the office of the Jackson County Surveyor, per clients request.

PROCEDURE:

Previous survey control established in the immediate area has been destroyed by construction of the Super 8 Motel and the present Les Schwab Tire Center. survey control was established where needed. We then proceeded to calculated the relative locations between said survey control and those corner positions which were in need of re-monumentation and set or re-set corner monuments as required. All other data is as shown on the accompanying map.

## BASIS OF BEARING:

True Meridian at the N-S Centerline of Section 14, as derived from the National Oceanic and Atmospheric Administration (formerly Coast and Geodetic Survey) survey net established in 1968 and filed in the office of the Jackson County Surveyor.

July 9, 1990

ref: LS1410T.nar

Swain Surveying, Inc. 27 1/2 North Main Street Ashland, Oregon 97520

Tax Lots 100, 101 and 200, 39-1E-14B

\* \* RECEIVED \* \* Date 7-11-90 By BS This survey Consists of: ¹ sheet(s) Map page(s) Narrative JACKSON COUNTY SURVEYOR

REGISTERED **PROFESSIONAL** LAND SURVEYOR