
## Map of Survey

Located in the Northeast quarter of the Southwest quarter of Section 10, Township 34 South, Range I West of the Willamette Meridian, Jackson County, Oregon.

for

## CITY of SHADY COVE

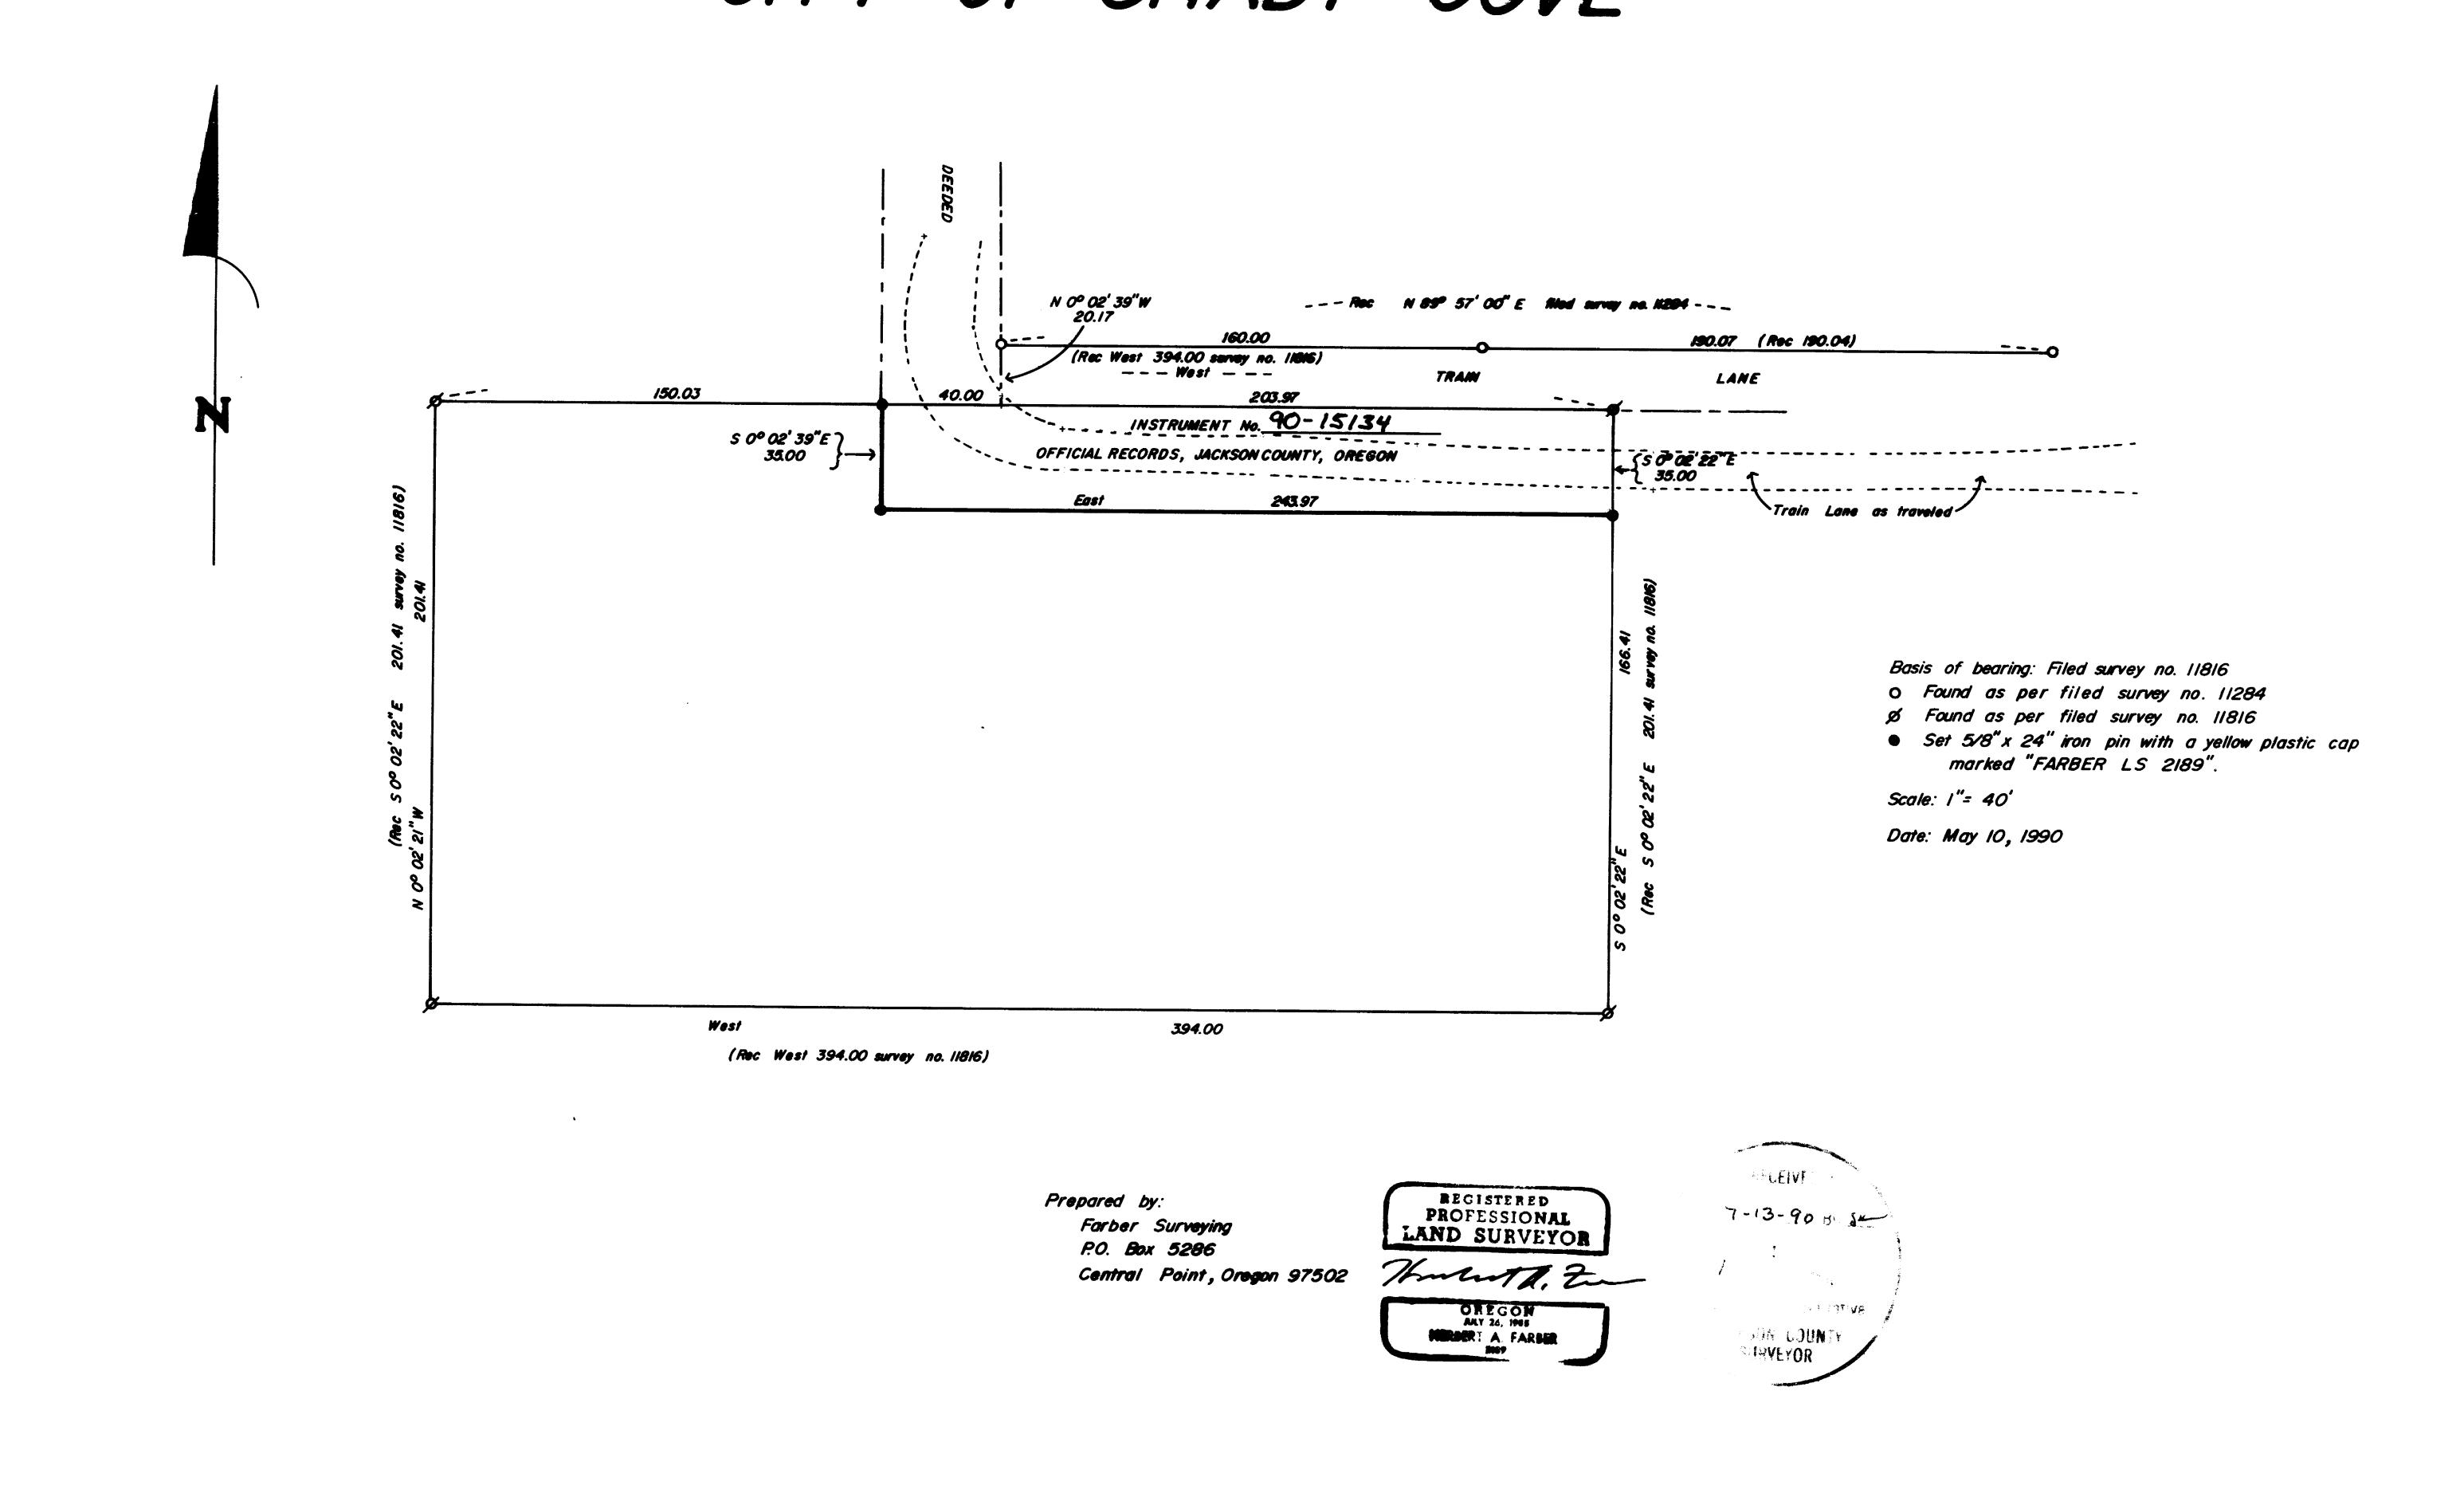

Tax Lot 1000

Map no. 34/WIOC

12114

## Survey No. 12114

## SURVEY NARRATIVE TO COMPLY WITH O.R.S. 209.250

Survey for:

City of Shady Cove P.O. Box 1210

Shady Cove, Oregon 97539

Location:

Located in the northeast quarter of the

southwest quarter of Section 10, Township 34 South, Range 1 West of the Willamette

Meridian, Jackson County, Oregon.

Purpose:

To monument the property deeded to the city

for the purpose of a city street.

Procedure:

Utilizing control establish in the performance

of filed survey no. 11816 I set the corners as

shown on the accompanying map.

Bearing is based on the north line of filed

survey no. 11816.

Surveyed by:

Farber Surveying

P.O. Box 5286

Central Point, Oregon 97502

Date:

May 10, 1990

\* \* RECEIVED \* \* Date 7-13-34 By SK REGISTERED PROFESSIONAL This survey Consists of: LAND SURVEYOR /\_\_ sheet(s) Map page(s) Narrative OREGON JULY 26, 1985 JACKSON COUNTY HERBERT A. FARBER SURVEYOR