



PLAT OF SURVEY

LOCATED in the NE 1/4 of Section 10, T. 33 S., R. 2 E., W.M., Jackson County, Oregon.

August 15, 1990

SURVEYED FOR: Ron & Debbie Howard
1780 Mill Creek Road
Prospect, Oregon 97536

SURVEYED BY: Edwards Surveying and Land Planning Inc.
1014 East Pine Street
Central Point, Oregon 97502
Phone: (503) 664-1539

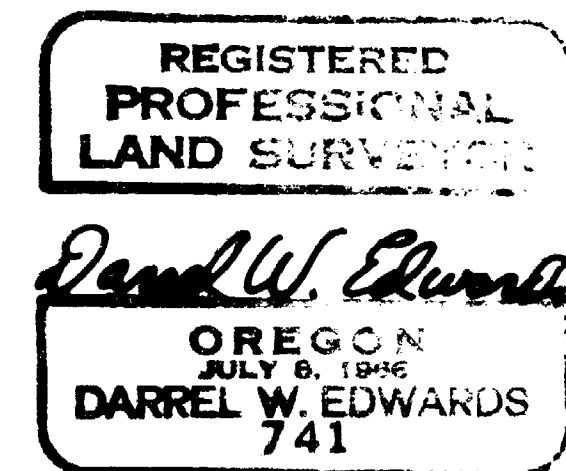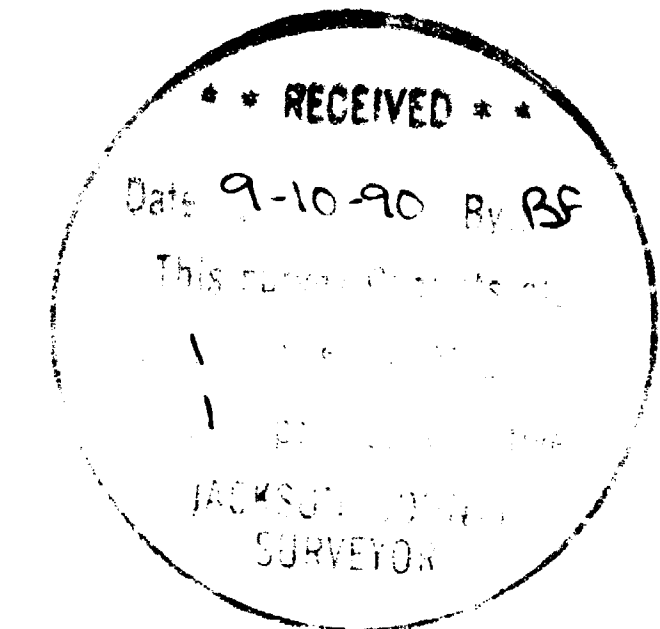

LEGEND

- Indicates monument found as noted.
- Indicates 5/8" x 24" steel pin w/plastic cap mkd. "D.W. EDWARDS-PLS 741" set.
- () Denotes Record Data
- J.C.S. = Jackson County Surveyor
- R.S.N. = Recorded Survey Number
- SCALE: 1" = 400'
- BASIS OF BEARINGS: Recorded Survey Number 1098.
- x-x-x- Fence Line

12181

SURVEY NUMBER

Edwards Surveying and Land Planning Inc.
Registered Land Surveyors
1014 East Pine St.
Central Point, Oregon 97502
(503)664-1539

SURVEY NARRATIVE TO COMPLY WITH CHAPTER 209, PARAGRAPH 250,
OREGON REVISED STATUTES

SURVEY FOR: Ron and Debbie Howard
1780 Mill Creek Road
Prospect, Oregon 97536

LOCATION: In the NE 1/4 of Section 10, T. 33 S., R. 2 E.,
W.M., Jackson County, Oregon.

PURPOSE: To locate and monument the boundaries of that
tract described in Document Number 89-25979,
official records.

PROCEDURE: Made ties to controlling Government corners and
right of way monuments as shown on the attached
plat. From this data, computed the tract
boundaries as shown on the accompanying plat.
Utilized the found monument per R.S.N. 10728 on
the East-West center line of the Section and
data found in said survey to compute the
position for the center 1/4 corner. Monuments
set on this survey consist of 5/8" x 24" steel
pins with yellow plastic caps mkd. "D.W.
EDWARDS-PLS 741". See accompanying plat for
locations.

BASIS OF
BEARINGS: Recorded Survey Number 1098

EQUIPMENT: Nikon NTD-4 Semi-automatic theodolite/E.D.M.

DATE
COMPLETED: August 15, 1990

** RECEIVED **
Date 9-10-90 By BS
This survey Consists of:
1 sheet(s) Map
1 page(s) Narrative
JACKSON COUNTY
SURVEYOR

REGISTERED
PROFESSIONAL
LAND SURVEYOR

Darrel W. Edwards
OREGON
DARREL W. EDWARDS
741