

SCALE 1"=100'

Basis of Bearings R.S. No. 6373

**LEGEND**

- ⊙ = Fd. B.L.M. 2" I. Pipe w/ br. disc and BT's
- = Fd. 5/8" I. Pin at Road R/W control points
- = Set 5/8" x 24" I. Pin (tagged R.P.L.S. 638)

REGISTERED  
PROFESSIONAL  
LAND SURVEYOR  
*George Burrell*  
OREGON  
JULY 10, 1984  
GEORGE R. BURRELL  
638

\*\* RECEIVED \*\*  
Date 10-1-90 by Sec  
The  
JAMES  
SURVEYOR

**MAP OF SURVEY**

Located in the N.E. 1/4 Section 30, T38S, R3E  
For: DON SKILLMAN  
By: George Burrell, R.P.L.S., 1379 Brookdale  
Medford, Oregon, 97504 Sept. 20, 1990

SURVEY NARRATIVE TO COMPLY WITH O.R.S. 209.250

FOR:

Don Skillman  
P.O. Box 381  
Ashland, OR 97520

LOCATION:

The N.E. 1/4 of Section 30, Twp. 38 South, Range 3 East

PURPOSE:

To monument the corners of tax lots no. 3803, 3809 and 3811-38-3E-30 as described in Document No. 71-02820 and 71-03700 of the Official Records of Jackson County.


PROCEDURE:

Random traverse control monuments of Recorded Survey No. 6373 were found and used as the basis of bearing and coordinate control for this survey. County Road R/W monuments were held for control of Dead Indian Road. The found B.L.M. monuments were held as control for the N-S centerline of the N.E. 1/4 of Section 30 and the line common to Sections 19 and 30.

The South boundary of tax lots 3803, 3809 and 3811 were established and described as shown on the accompanying map for boundary line agreement purposes.

BY:

George Burrell, R.P.L.S.  
1379 Brookdale Road  
Medford, Oregon 97504  
Sept. 20, 1990

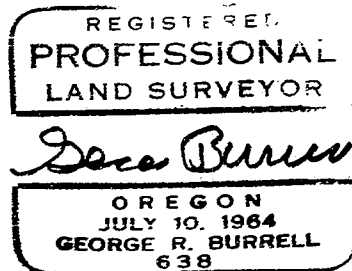

T.L. No. 3803, 3809 and 3811-38-3E-30

