

Survey No. 1222

Paul Rynning
County Surveyor
Medford, Oregon

Subject: Re-establishment of Section Corner


Township 38 South, Range 2 West, Willamette Meridian.

Section corner 4, 5, 8 and 9, Set a $1\frac{1}{2}$ inch iron pipe, 28 inches long, 26 inches deep.

Found original B.T., a white oak, now 22 inches diam., bears N.42°E. 59 lks., B.T. visible.

A white oak, 6 ins. diam., bears S.56°E., 90 lks. mkd. 301 B T.

A fir, 8 ins. diam., bears S.76°W., 82 $\frac{1}{2}$ lks. mkd. 301 B T.

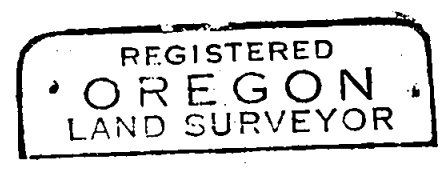

Edward A. McGinty

