


1233


1233

Survey For
GENERAL DEVELOPMENT CO.
 Located in Block No. 3 of
CRATER PARK SUBDIVISION
 Sec. 33, T.36S.R.2W., W.M.
 By : Mark E. Boyden
 March 1959.

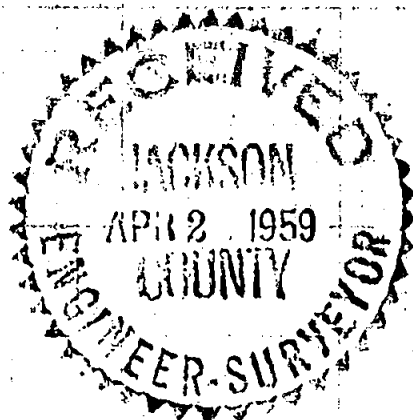

REGISTERED
OREGON
 LAND SURVEYOR

Mark E. Boyden
 NOVEMBER 9, 1951
MARK E. BOYDEN
 281

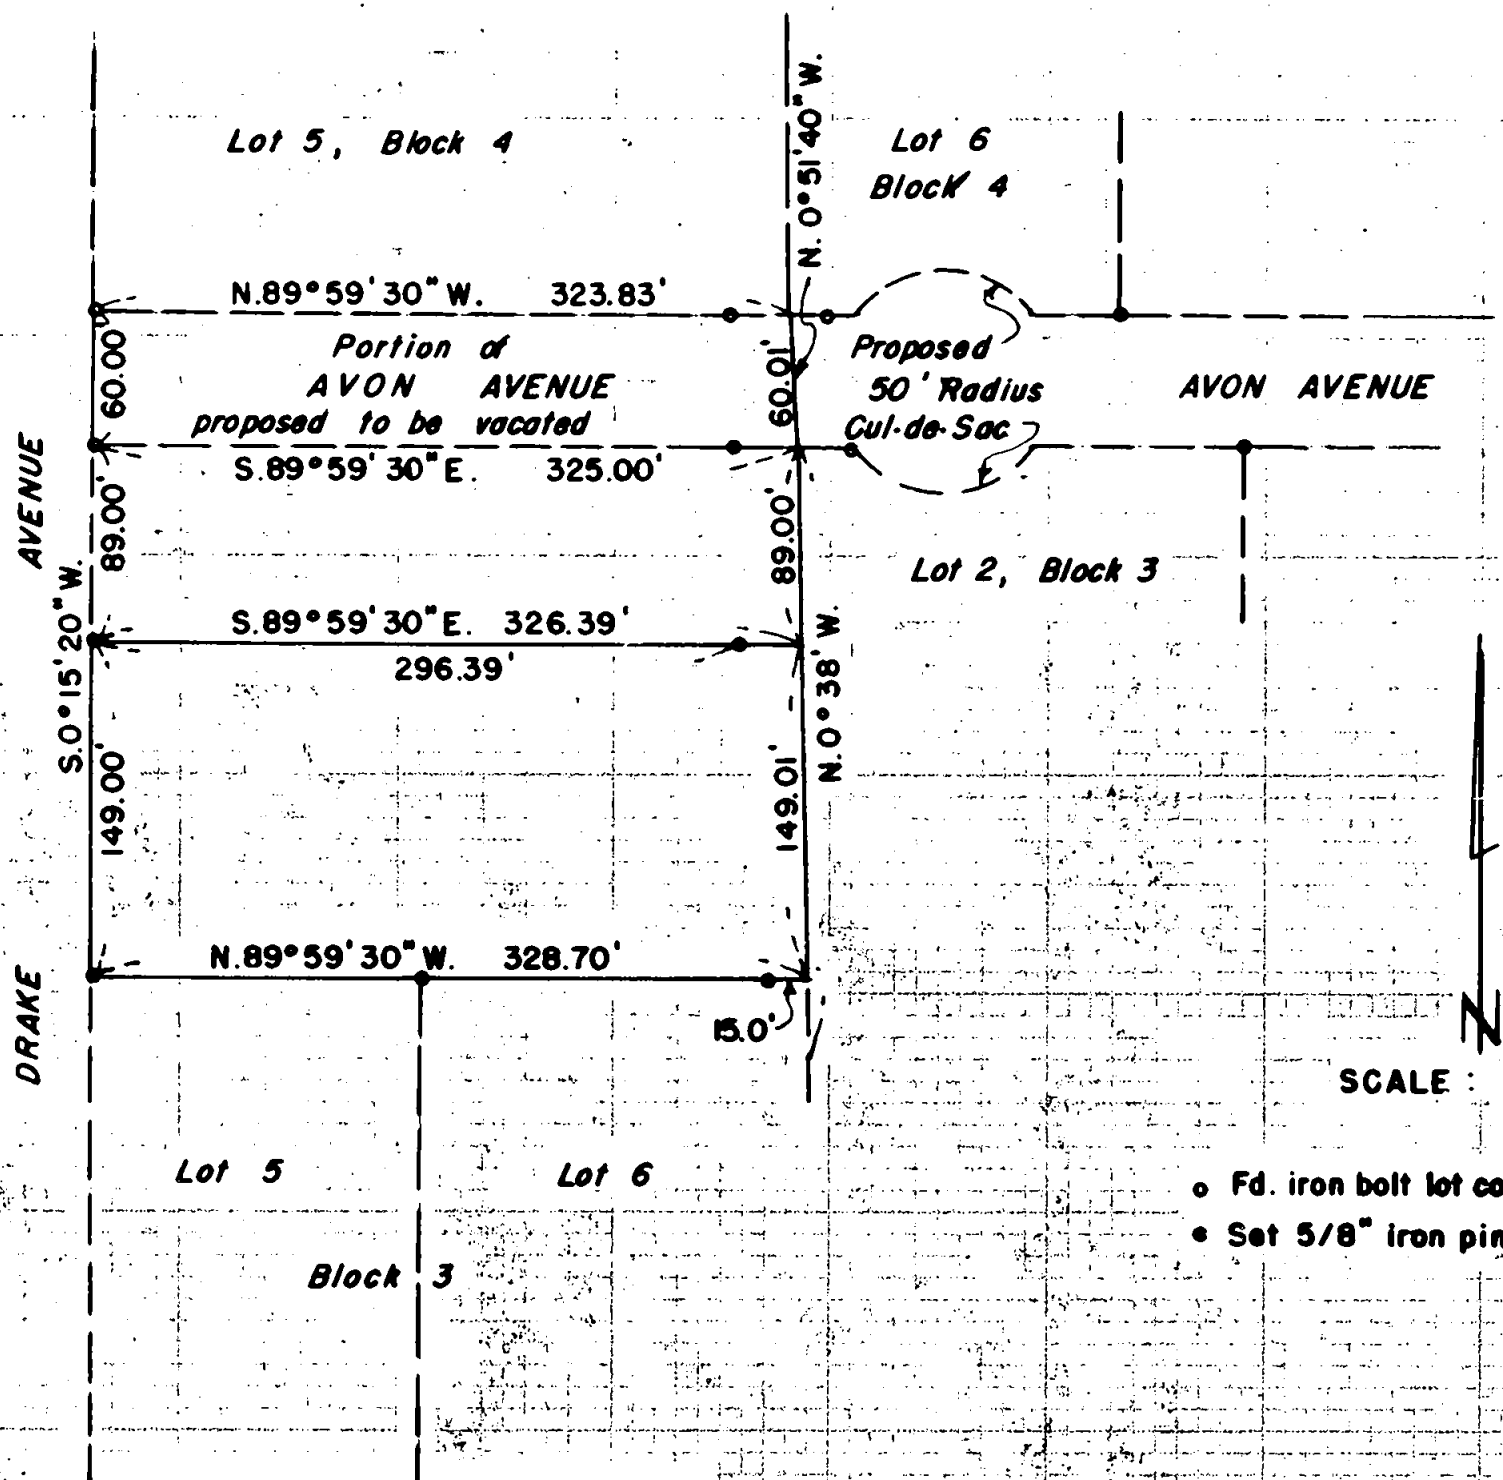

Survey Narrative to Comply With Paragraph 209.250

Oregon Revised Statutes

FOR: General Development Co.

PURPOSE: To monument an East-West division line through Lots 3 and 4 of Block No. 3 of CRATER PARK SUBDIVISION as directed. Also to describe the following:

1. That portion of Avon Avenue proposed to be vacated.
2. The proposed cul-de-sac arcs in Lot 6, Block 4 and in Lot 2, Block 3.
3. The lot fronting Drake Avenue lying South of said established division line.
4. The lot fronting Drake Avenue lying North of said established division line which also includes that portion of Avon Avenue proposed to be vacated.

PROCEDURE: Found iron bolt monument controls as originally set by this office, setting 5/8" iron pins as indicated.

March 1959

