


1235

SURVEY IN SEC. 24 T. 39 S., R. 1 E., W.M.  
FOR  
R. VAN VLEET

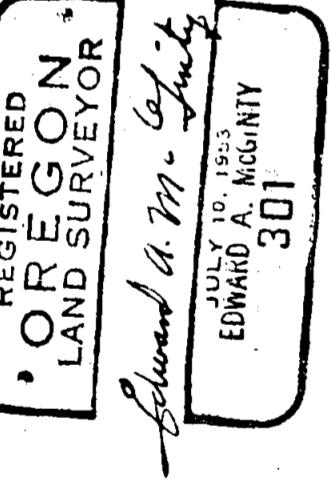


SSE. Cor. DLC. 54

BY EDWARD MC GINTY  
MEDFORD, OREGON  
MARCH 6, 1959

SCALE 1" = 200'  
◎ = 1 1/2" PIPE  
○ = 5/8" PIN

SOLAR OBSER

WSW. Cor. DLC. 55

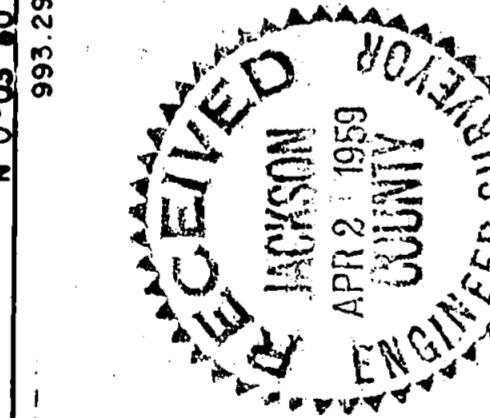

1395.16' N 0° 03' 40" E


993.29' N 0° 03' 10" W

938.11' N 89° 56' 20" E

1682.49' FD. Sandstone NE. Cor. DLC. 55

SE. COR.  
DLC. 56

DLC OF

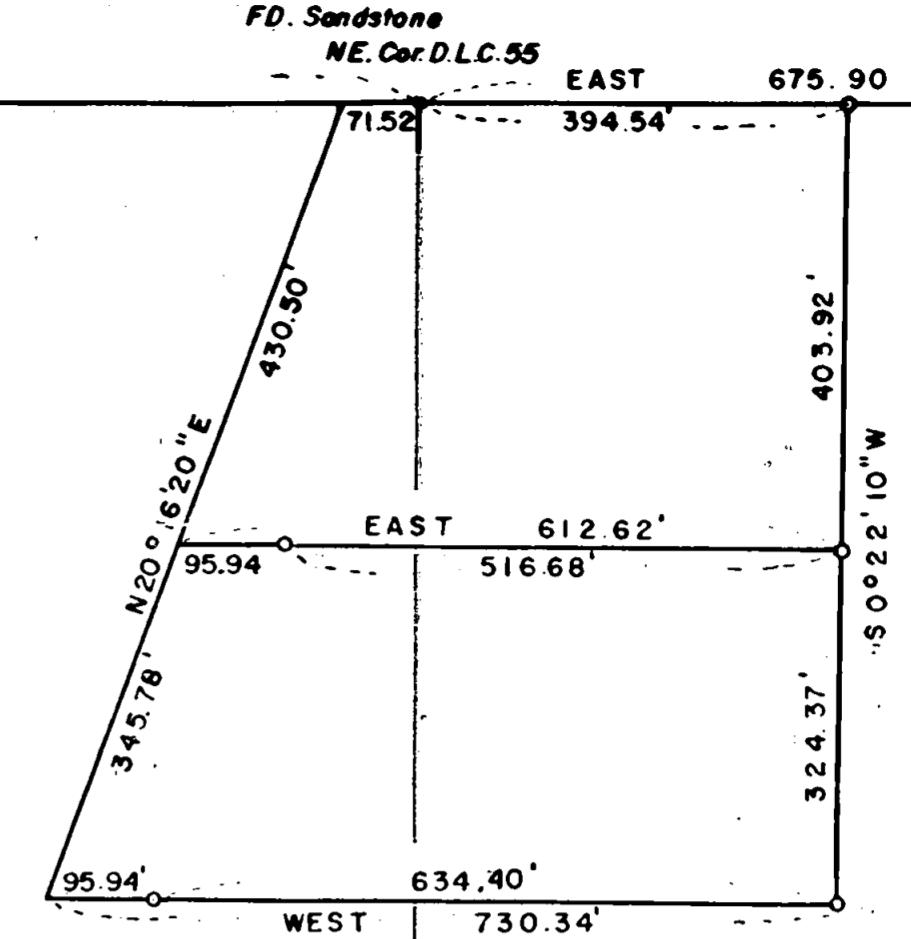NW. Cor.  
DLC. 59

1235  
Survey No. \_\_\_\_\_

Survey Narrative to comply with O.R.S. 209-205 and O.R.S. 209-120

Survey for: Mr. R. Van Vleet

Survey by: Edward A. McGinty, L.S. 3/6/59

BASIS OF BEARING: Solar observation

PRECEDENCE OF SURVEY:

Found a granite stone at the north northwest corner of Donation Land Claim No. 55 and a sand stone at the northeast corner of Donation Land Claim No. 55. At the southeast corner of Donation Land Claim No. 55, a resident of many years showed me the original B T to the northwest where it had been and now is a sunken stump hole in the earth. Distance to the bearing tree from original notes was held and a course East from the northeast corner of Donation Land Claim No. 55, was held to set corner as shown, as the exact center of old stump hole, after considerable digging, could not be determined.

REGISTERED  
OREGON  
LAND SURVEYOR

JOSEY 10. 1955  
EDWARD A. MCGINTY  
301

