12366

MAP OF SURVEY

FOR:

NICHOLAS D. AND DIANA P. BROUSSARD

LOCATED IN:

S.W. 1/4 of Section 26 and N.W. 1/4 of Section 35,
T.38S., R.1W., W.M., Jackson County, Oregon

* See affidavit of correction 93-13120 4/26/1993

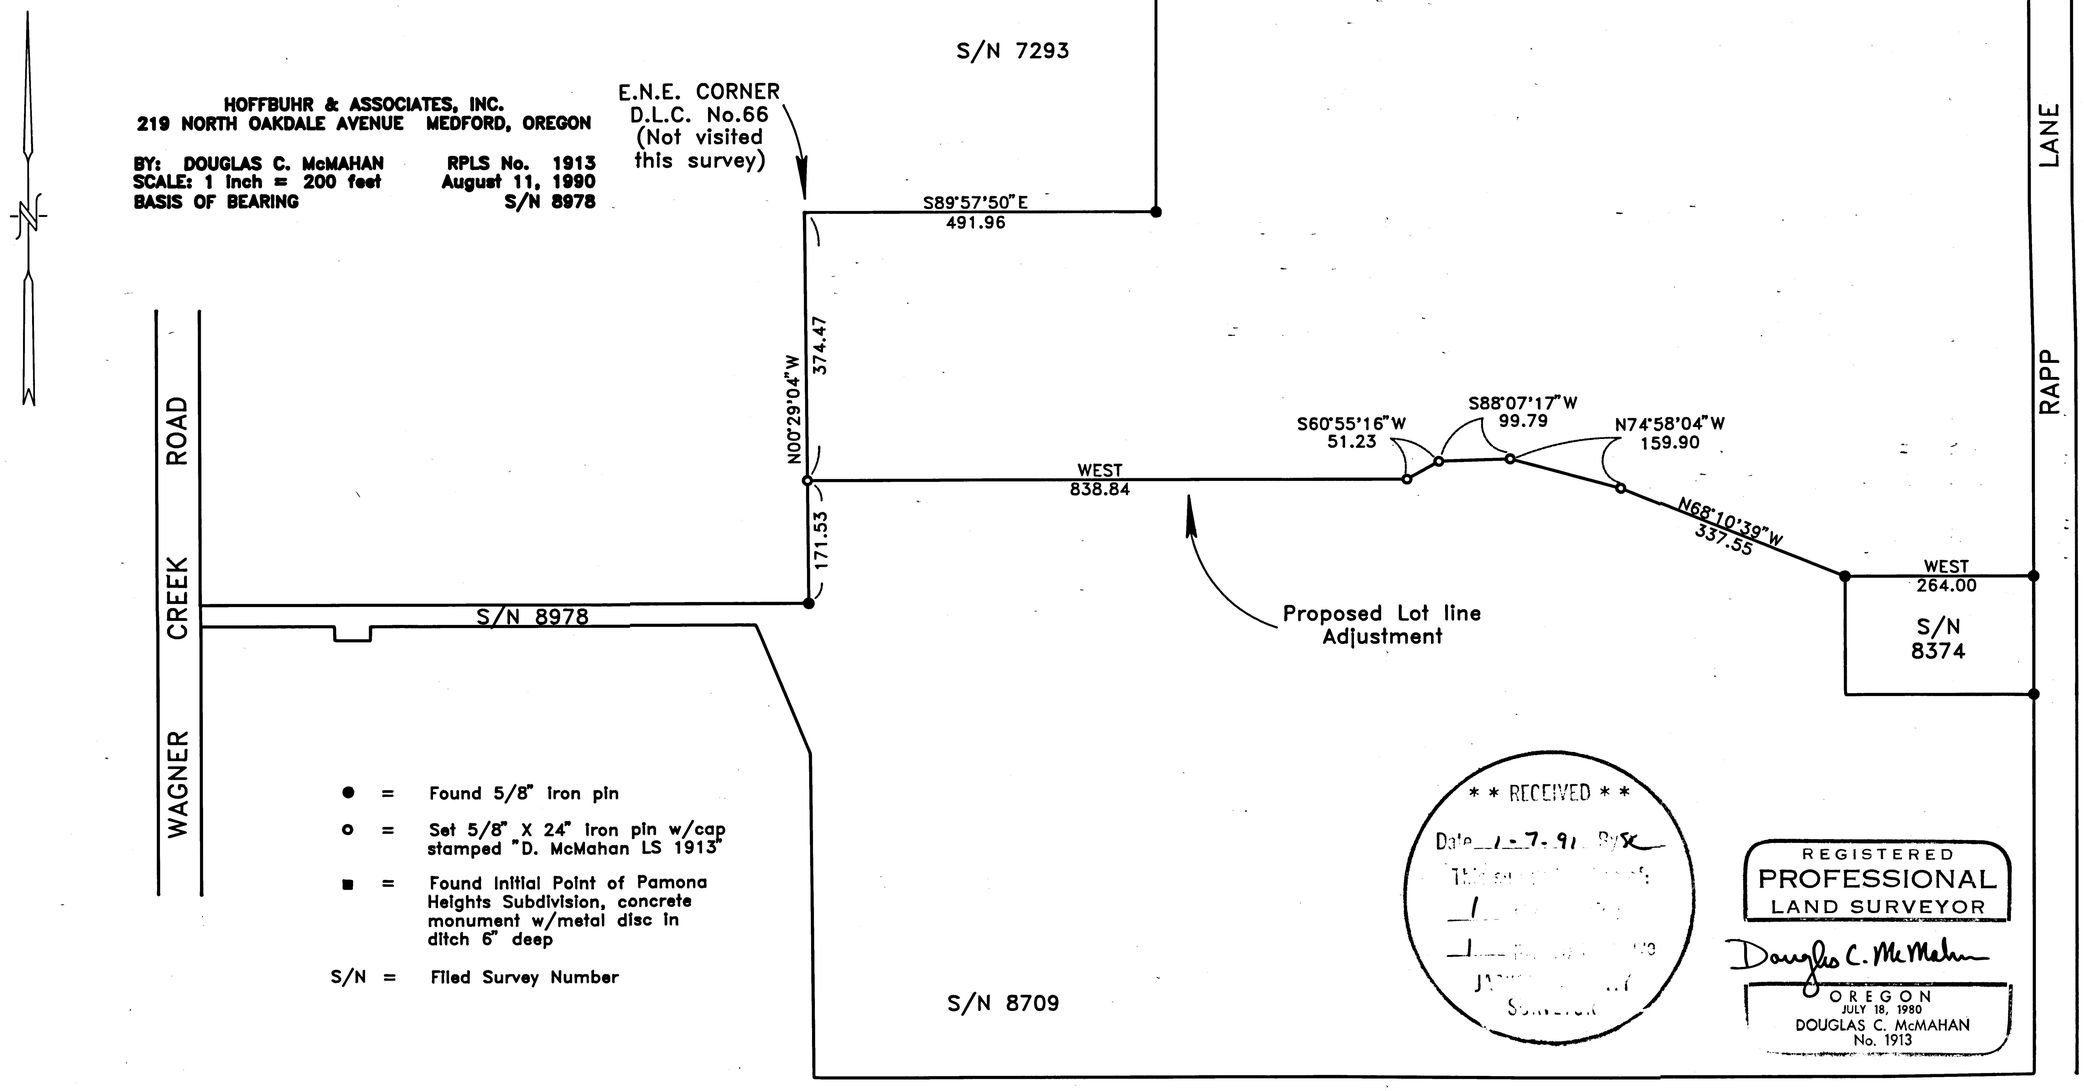

38 IW 26C T.L.800 & 38 IW 35 T.L.690

12366

SURVEY NO. 12366

SURVEY NARRATIVE TO COMPLY WITH PARAGRAPH 209.250 OREGON REVISED STATUTES

SURVEY FOR: Nicholas D. and Diana P. Broussard
7140 Rapp Lane
Talent, Or. 97540

LOCATION: Southwest one-quarter (1/4) of Section 26 and Northwest one-quarter (1/4) of Section 35, Township 38 South, Range 1 West, Willamette Meridian, Jackson County, Oregon.

PURPOSE: To survey and monument a line as determined by the clients.

PROCEDURE: Utilizing control established during Survey No. 8709 and Survey No. 8978, a line was marked with monuments at locations specified by the clients and as shown on the attached plat.

BASIS OF BEARING: Survey No. 8978

DATE: August 11, 1990

* * RECEIVED * *
Date 1-7-91 By SK
This survey Consists of:
1 sheet(s) Map
1 page(s) Narrative
JACKSON COUNTY SURVEYOR

REGISTERED PROFESSIONAL LAND SURVEYOR
Douglas C. McMahan
OREGON
JULY 18, 1980
DOUGLAS C. McMAHAN
No. 1913

Douglas C. McMahan
Hoffbuhr & Assoc. Inc.
219 North Oakdale
Medford, Or. 97501

93-13120

12366

5.00
Surfe 6.00
3:08

HOFFBUHR & ASSOCIATES, INC.
1062 E. Jackson Street
Medford, Oregon 97504-7027

(503) 779-4641

AFFIDAVIT OF CORRECTION
pursuant to O.R.S. 209.255

I, Douglas C. McMahan, Registered Professional Land Surveyor of the State of Oregon, No. 1913, do hereby state that I have discovered a drafting error on my Map of Survey for *NICHOLAS D. and DIANA P. BROUSSARD*, filed for record the 7th day of January 1991, in Office of Jackson County Surveyor as: County Surveyor File No. 12366.

Douglas C. McMahan, L.S. 1913

REGISTERED
PROFESSIONAL
LAND SURVEYOR

Douglas C. McMahan

OREGON
JULY 18, 1980
DOUGLAS C. McMAHAN
No. 1913

Expires 12/31/94

STATE OF OREGON)
County of Jackson) ss.

4/26 A.D. 1993

Personally appeared the above named Douglas C. McMahan, a Registered Professional Land Surveyor, and acknowledged the foregoing instrument to be his voluntary act and deed.
Before me:

Cheryl A. Ferns
CHERYL A. FERNS
NOTARY PUBLIC – OREGON
My Commission Expires 12-23-93

The correction is: (Section No. in Title of Map)

As filed: "and N.W. 1/4 of Section 25,"

Change to: "and N.W. 1/4 of Section 35,"

The Jackson County Surveyor hereby certifies that this Affidavit of Correction has been examined an approved for recording.

April 26, 1993
Date

Evelyn Thomas
Jackson County Surveyor

(affcorr.dcm)

Jackson County, Oregon
Recorded
OFFICIAL RECORDS
3:08 APR 26 1993 P M.
KATHLEEN S. BECKETT
CLERK and RECORDER
By J. Ramelez Deputy