

CERTIFIED RECORD OF LAND CORNER MONUMENTATION


12385

History of original corner establishment:

Original stone was established by Campbell under contract number 747 dated May 5, 1902

Shaner set an iron pipe alongside original stone in 1970 under USFS contract

Moffit found original stone and BTs by Shaner, but no pipe under USFS contract in 1986

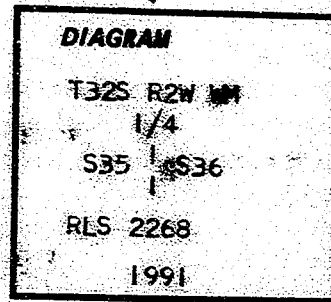

Description of corner evidence found:

Found original 18"x12"x36" granite stone with "1/4" on West face and "X" on top 12" above ground

30" D.Fir bears S 47 1/2° W, 80.9 feet to face, scribes visible on open blaze

18" D.Fir bears S 28° E, 9.2 feet, healed blaze

Description of monument and accessories I established to perpetuate the original location of this corner:

set 2"x 36" iron pipe with a 2 1/2" brass cap 18" above ground in a 36" diameter rock mound and 18" high, marked as shown above.

I painted the "X" on the original stone and then inverted, in 36" diameter rock mound

14" D.Fir bears N 9° W, 20.0 feet I scribe "1/4 S35 BT" with alum. tag marked "ARTMAN RLS 2268" nailed flush to BT face.

14" D.Fir bears East, 22.3 feet I scribe "1/4 S36 BT" with alum. tag marked "ARTMAN RLS 2268" nailed flush to BT face.

REGISTERED
PROFESSIONAL
LAND SURVEYOR

J. D. Artman

OREGON
JULY 16, 1987
JAMES D. ARTMAN
2268

JACKSON COUNTY
RECEIVED
FEB 5 1991
SURVEYOR

Office of..... County of.....
State of..... I hereby certify that the within instrument was filed in this office
for record on the..... day of....., 19.....

..... by
(COUNTY OFFICIAL) (DEPUTY)