


12393

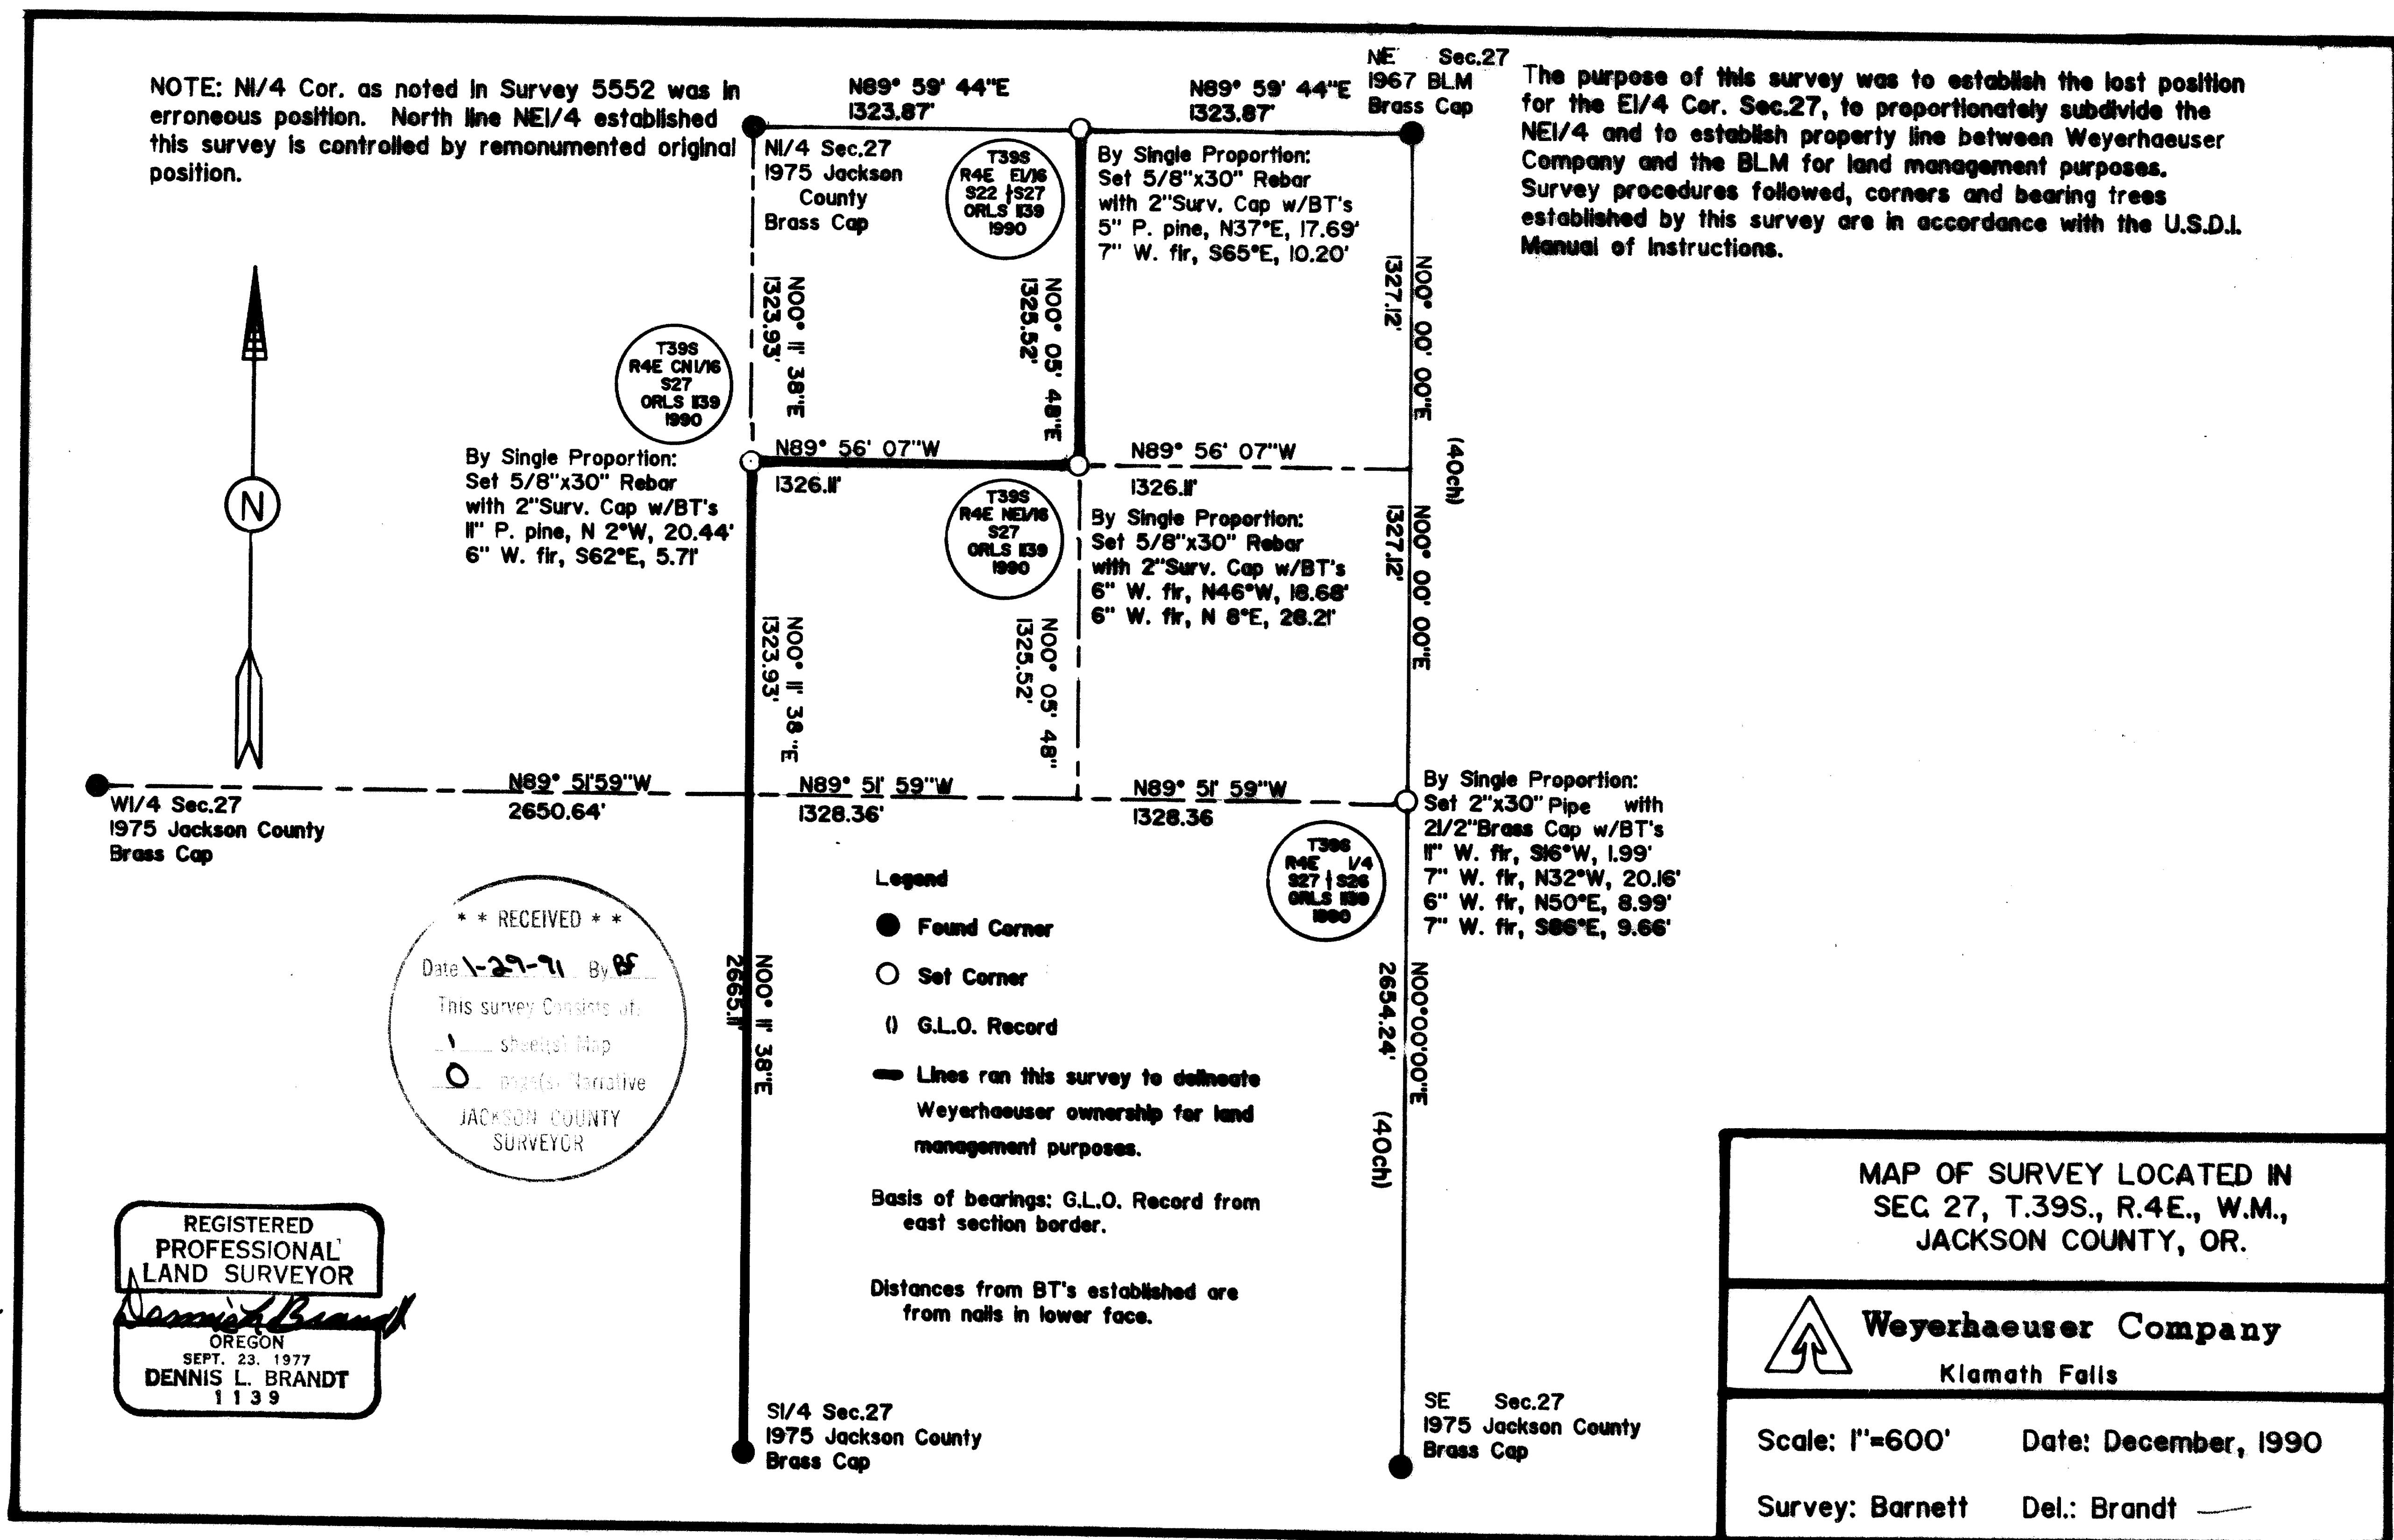

12393