

REGISTERED
OREGON
 LAND SURVEYOR

Edward A. McGinty

JULY 10, 1953
EDWARD A. MCGINTY
 301

**SURVEY IN LOTS 1&13 BLK. 3, C & D SUB'D.
 FOR
 G. ARMSTRONG**

BY EDWARD MCGINTY
 MEDFORD, OREGON
 MAY 11, 1959

SCALE 1" = 80'
 ● = 1" AXLE
 ○ = 3/4" PIPE

Survey No. 1246


Survey Narrative to comply with C.R.S. 209-205 and O.R.S. 209-120

Survey for: Geo Armstrong

Survey by: Edward A. McGinty

PRECEDENCE OF SURVEY:

Determined the west line of Hamilton St. from a 3 inch brass cap at the southeast corner of lot 24 and a 1/2 inch iron pipe on the east line of Hamilton St., being on the north line of Twelfth St. The south line of block 3 was determined from the remains of an old wood corner stake as shown. The center line of Eleventh St. was determined by measuring record distance to the north along Hamilton St. and monuments in Lincoln St. as shown. Made surveys in lots 1 and 13 as requested by client.

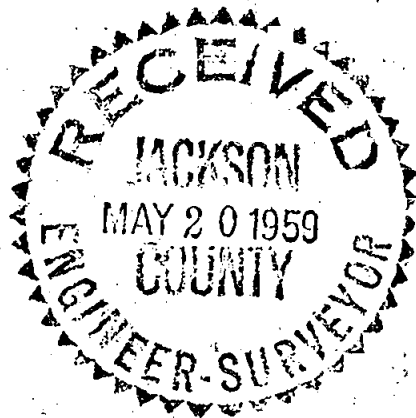

Edward A. McGinty
JULY 10, 1953
EDWARD A. MCGINTY
301