


1776

1248

1248

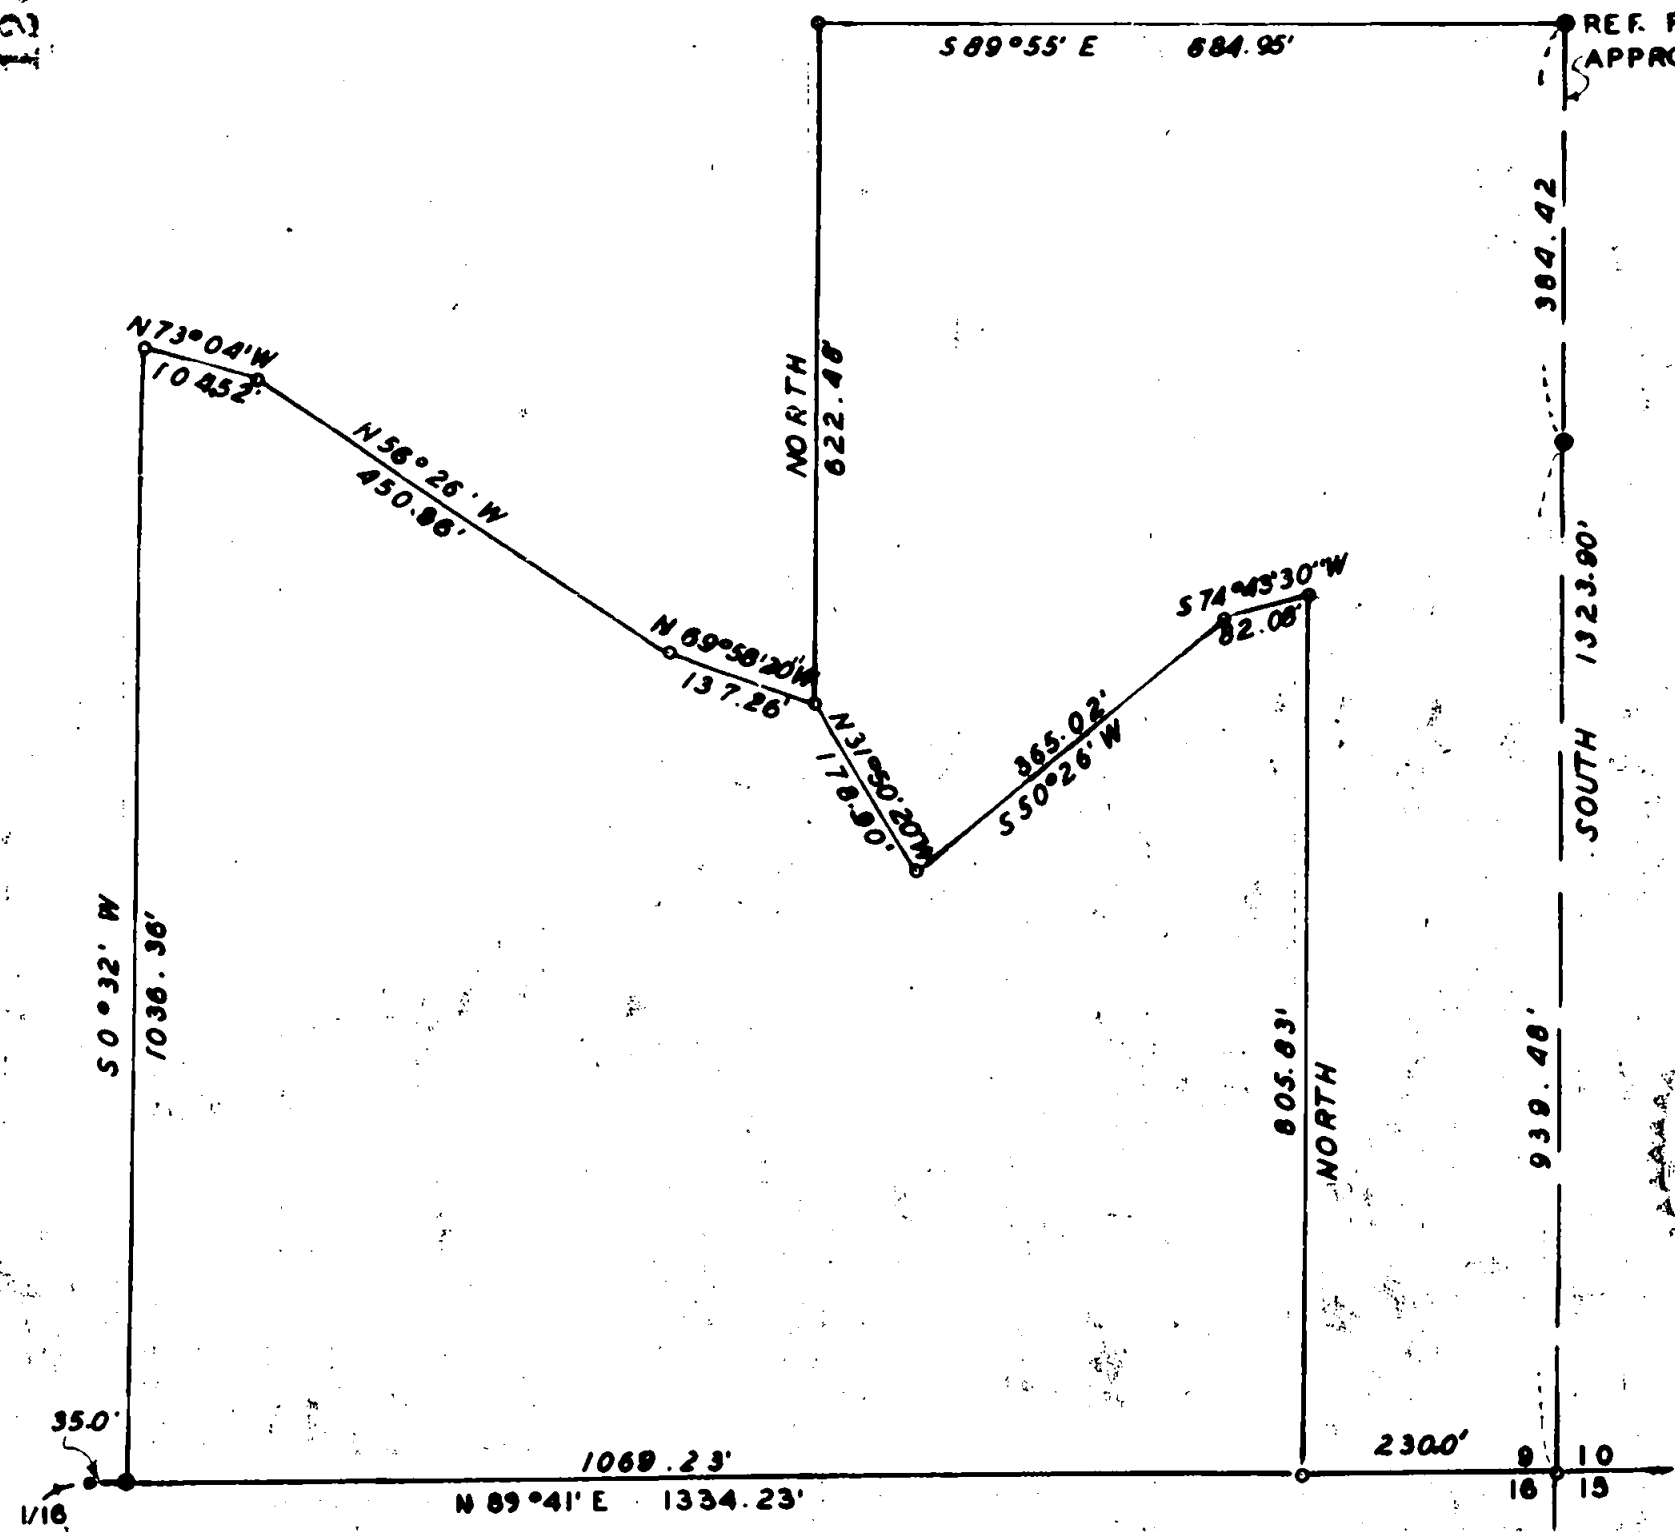

SURVEY IN SEC. 9 T.38S., R.2W., W.M.
FOR
H. HUKILL

BY EDWARD MC GINTY
MEDFORD, OREGON
APRIL 16 1959

SCALE 1" = 200'
○ 3/4" PIPE
● 1" PIPE



REGISTERED
OREGON
LAND SURVEYOR

Edward A. McGinty

JULY 10, 1953
EDWARD A. MCGINTY
301

SOLAR OBSER

Survey No. 1248

Survey Narrative to comply with O. R. S. 209-205 and O. R. S. 209-120

Survey for: H. Hukill

Survey by: Edward A. McGinty 4/16/59

BASIS OF BEARING: Solar Observation.

PRECEDENCE OF SURVEY:

Determined the south line from the East 1/16 corner, between Sections 9 and 16, finding a 3/4 inch iron pin and 2 BT's. At the southeast corner of Section 9, found a stake in place and 3 original BT's. Set a 3/4 inch iron pipe at said corner. The East line of Section 9 was not determined on this survey as shown to be, only the approximate Section line. Divided 2 separate parcels and set corners in position at request of client for possible sale. Note; reference points set on approximate east line of Section 9.



Edward A. McGinty

