


1" = 200'

**LEGEND**

- ⊙ FOUND BRASS CAP MONUMENT PER JACKSON COUNTY RE-ESTABLISHMENT
- FOUND BRASS CAP MONUMENT PER R.S. NO. 8364
- △ CALCULATED POSITION
- SET 5/8" x 30" REBAR WITH YELLOW PLASTIC CAP MARKED "TEMPLIN 2359"
- TRUE LINE BLAZED AND PAINTED RED
- ( ) RECORD DEED BEARING / DISTANCE
- [ ] RECORD BEARING / DISTANCE PER R.S. NO. 8364

BEARINGS ARE BASED UPON RECORDED SURVEY NUMBER 8364 AS SHOWN.

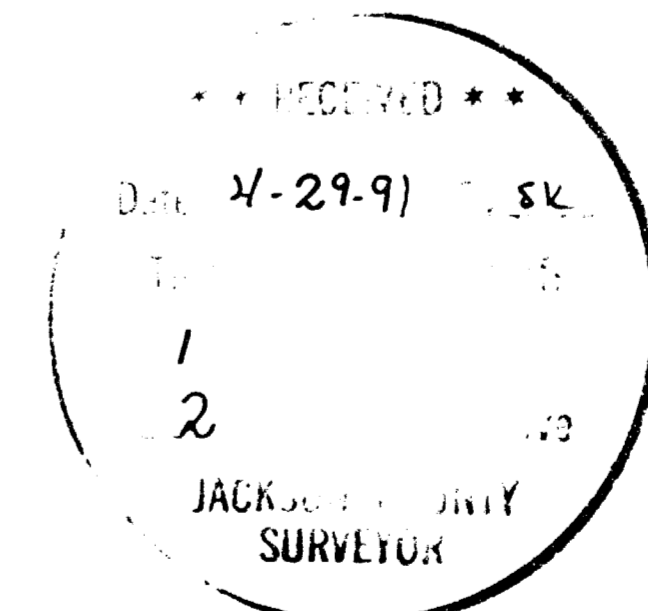

REGISTERED  
PROFESSIONAL  
LAND SURVEYOR  
*Richard Templin*  
RICHARD TEMPLIN

**RICHARD TEMPLIN LAND SURVEYING**  
2042 SANDRA PL 776-0991 & 474-7720 MEDFORD, OREGON

**PLAT OF SURVEY**

LOCATED IN  
SE 1/4 OF SECTION 30, T.32S., R.3E., W.M., JACKSON COUNTY, OREGON  
SURVEY FOR: BOISE CASCADE CORP. DATE: APRIL 22, 1991  
P.O. BOX 100  
MEDFORD, OREGON 97501

32-3E-SE 1/4 SEC. 30

**RICHARD G. TEMPLIN**  
PROFESSIONAL LAND SURVEYOR  
2042 Sandra Pl.  
Medford, Oregon 97504  
(503) 776-0991 • 474-7720

SURVEY NO. 12487

SURVEY FOR: Boise Cascade Corp.  
P.O. Box 100  
Medford, Oregon 97501

Location: SE 1/4 of Section 30, Township 32 South,  
Range 3 East of the Willamette Meridian,  
Jackson County, Oregon.

Purpose: To monument the C-W-E-E 1/256, C-W-NE-SE  
1/256, NE-SE 1/16 corners of Section 30, also  
monument the Northerly line of exception "a"  
Parcel 3, Vol. 531, Pg. 204 of the Official  
Deed Records of Jackson County.

Date: April 22, 1991

Basis of  
Bearing: Based upon the South line of Section 30 per  
Recorded Survey number 8364.

Procedure: Utilizing a Nikon Topgun A-10 total station  
tied Center, East, South Quarter Corners, SE  
corner of Section 30 and the CE 1/16 corner as  
monumented by RS 8364. The calculated outside  
boundary of the SE 1/4 checked very close with  
Recorded Survey number 8364. However the CE  
1/16 corner was found N 71°53'54" W, 1.91 feet  
from my calculated position. I held my  
calculated position and ran N 89°18'58" East,  
324.46 feet to the C-W-E-E 1/256 corner from  
which I set:

A 5/8"x 30" Rebar, with a yellow plastic cap  
marked "TEMPLIN LS 2359", from which I scribe  
the following bearing trees:

A Douglas Fir, 10" diameter bears N 28° E,  
9.2 feet, scribed "C-W-E-E 1/256" "BT".  
A Douglas Fir, 12" diameter bears N 28° W,  
6.0 feet, scribed "C-W-E-E-1/256" "BT".

**RICHARD G. TEMPLIN**  
PROFESSIONAL LAND SURVEYOR  
2042 Sandra Pl.  
Medford, Oregon 97504  
(503) 776-0991 • 474-7720

12487

I then run S 00°01'03" E, 662.65 feet to the C-W-NE-SE 1/256 corner from which I set:

A 5/8"x 30" Rebar, with a yellow plastic cap marked "TEMPLIN LS 2359", from which I scribe the following bearing trees:

A Douglas Fir, 18" diameter bears N 26° E, 5.9 feet, scribed "C-W-NE-SE 1/256" "BT".  
A Hemlock, 4" diameter bears S 40° E, 11.0 feet, scribed "C-W-NE-SE-1/256" "BT".

I then run N 89°18'31" E, 326.05 feet to the NE-SE 1/64 corner from which I set:

A 5/8"x 30" Rebar, with a yellow plastic cap marked "TEMPLIN LS 2359", from which I scribe the following bearing trees:

A Sugar Pine, 6" diameter bears N 60° E, 19.3 feet, scribed "NE-SE 1/64" "BT".  
A Douglas Fir, 10" diameter bears N 28° W, 6.8 feet, scribed "NE-SE 1/64" "BT".

I then run S 00°09'16" E, 662.59 feet to a point which is 300.00 feet Northwesterly of a survey line described in exception "a" of Parcel 3, Vol. 531, Pg. 204 of the Deed Records of Jackson County, Oregon. I then run line parallel and 300.00 feet northwesterly of said described line as shown on accompanying plat to the South line of Section 30.

The U.S.F.S. was notified of their position of the CE 1/16, as I find it. They are in the process of field checking their work, as of this date.

\*\* RECEIVED \*\*

Date 4-29-91 By SE

This survey Consists of:

1 sheet(s) Map  
2 page(s) Narrative

JACKSON COUNTY  
SURVEYOR

REGISTERED  
PROFESSIONAL  
LAND SURVEYOR

*M G T*

OREGON  
JULY 26, 1989  
RICHARD G. TEMPLIN  
2359