

12408

22  
27  
1/4 SEC. COR. T38S, R2E  
Fd. C.S. 1" br. capped pipe

2565.15

South

East 1523.74

S 59° 25' 00" W

575.68

N 51° 35' 00" W

344.60

T.L. No. 802-38-2E-27  
5.03 Ac.

N 59° 35' 10" W

556.33

460.00

COVE

R.S. NO. 5069

ROAD

30' 30"

N 38° 25' 00" E



SCALE 1"=60'


Basis of Bearings R.S. No. 5069

o = Set 5/8" x 24" I. Pin (tagged R.P.L.S 638)

REGISTERED  
PROFESSIONAL  
LAND SURVEYOR

*George Burrell*

OREGON  
JULY 10, 1964  
GEORGE R. BURRELL  
638

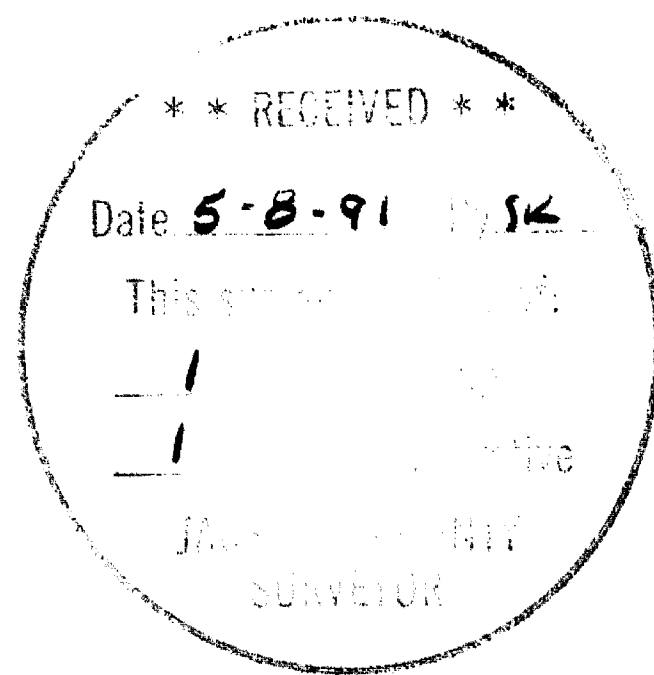

MAP OF SURVEY

Located in E 1/2 Section 27, T38S, R2E

For: RAY MITCHELL

By: George Burrell, L.S., 1379 Brookdale  
Medford, Oregon 97504 Feb. 27, 1991

12499

SURVEY NARRATIVE TO COMPLY WITH O.R.S. 209.250

FOR:

Ray Mitchell  
1001 Cove Road  
Ashland, Oregon 97520

LOCATION:

The East 1/2 of Section 27, Township 38 South, Range 2 East

PURPOSE:

To monument the corners of Tax Lot No. 802-38-2E-27


PROCEDURE:

This tax lot was described by me in 1978. Said lot was located and monumented according to record from found control monuments I established on Recorded Survey No. 5069 in 1972 along Cove Road.



BY:

George Burrell, R.P.L.S.  
1379 Brookdale Ave.  
Medford, Oregon 97504

Feb. 27, 1991

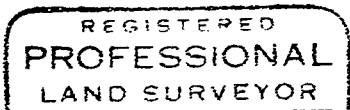

*George Burrell*

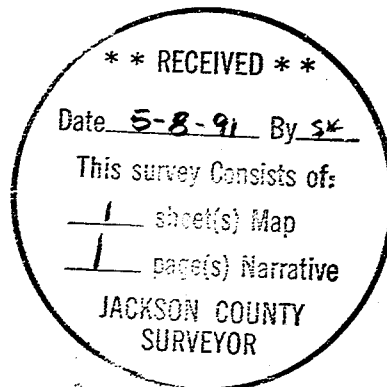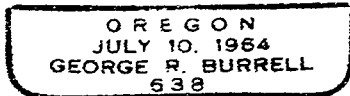

T.L. No. 802-38-2E-27