

REGISTERED  
OREGON  
LAND SURVEYOR

*Edward A. McGinty*

JULY 10, 1953  
EDWARD A. MCGINTY  
301

**SURVEY IN OAKDALE PARK ADD. D.L.C. 82, T37S, R.2W.  
FOR  
W. FERRIS**

BY EDWARD MCGINTY  
MEDFORD, OREGON  
MAY 1959

SCALE 1" = 100'  
● = AXLE FD.  
○ = 3/4" PIPE

Survey No. 1250

Survey Narrative to comply with (O.R.S. 209-120 and O.R.S. 209-206

Survey for: William Ferris

Survey by: Edward A. McGinty, L.S. 6/8/59



BASIS OF BEARING: Sur. No. 481 and Deed of record.

PRECEDENCE OF SURVEY:

The east line of the property was determined from monuments found along the center line of Peach Street.

The south, west and the northerly lines were determined from monuments found and as shown.

Set iron pipes as shown, at request of client.

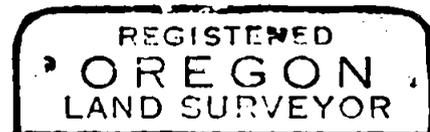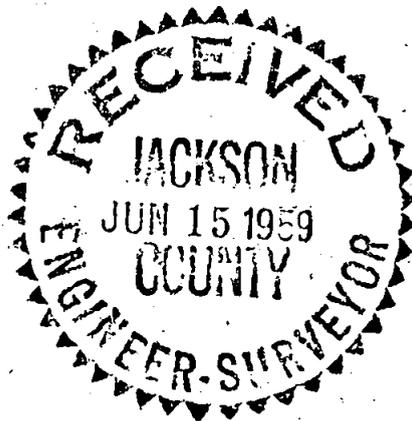

*Edward A. McGinty*

