

12520

12520


**SURVEY IN S½ SEC. 26, T. 34 S., R. 4 W., W.M., JACKSON, COUNTY, ORE.
MAY 3, 1991**

SURVEY FOR:

LEE FRAKES
815 SW 4TH ST.
GRANTS PASS, ORE.

SURVEY BY:

ROBERT MASON
415 SURREY DR.
GRANTS PASS, ORE.

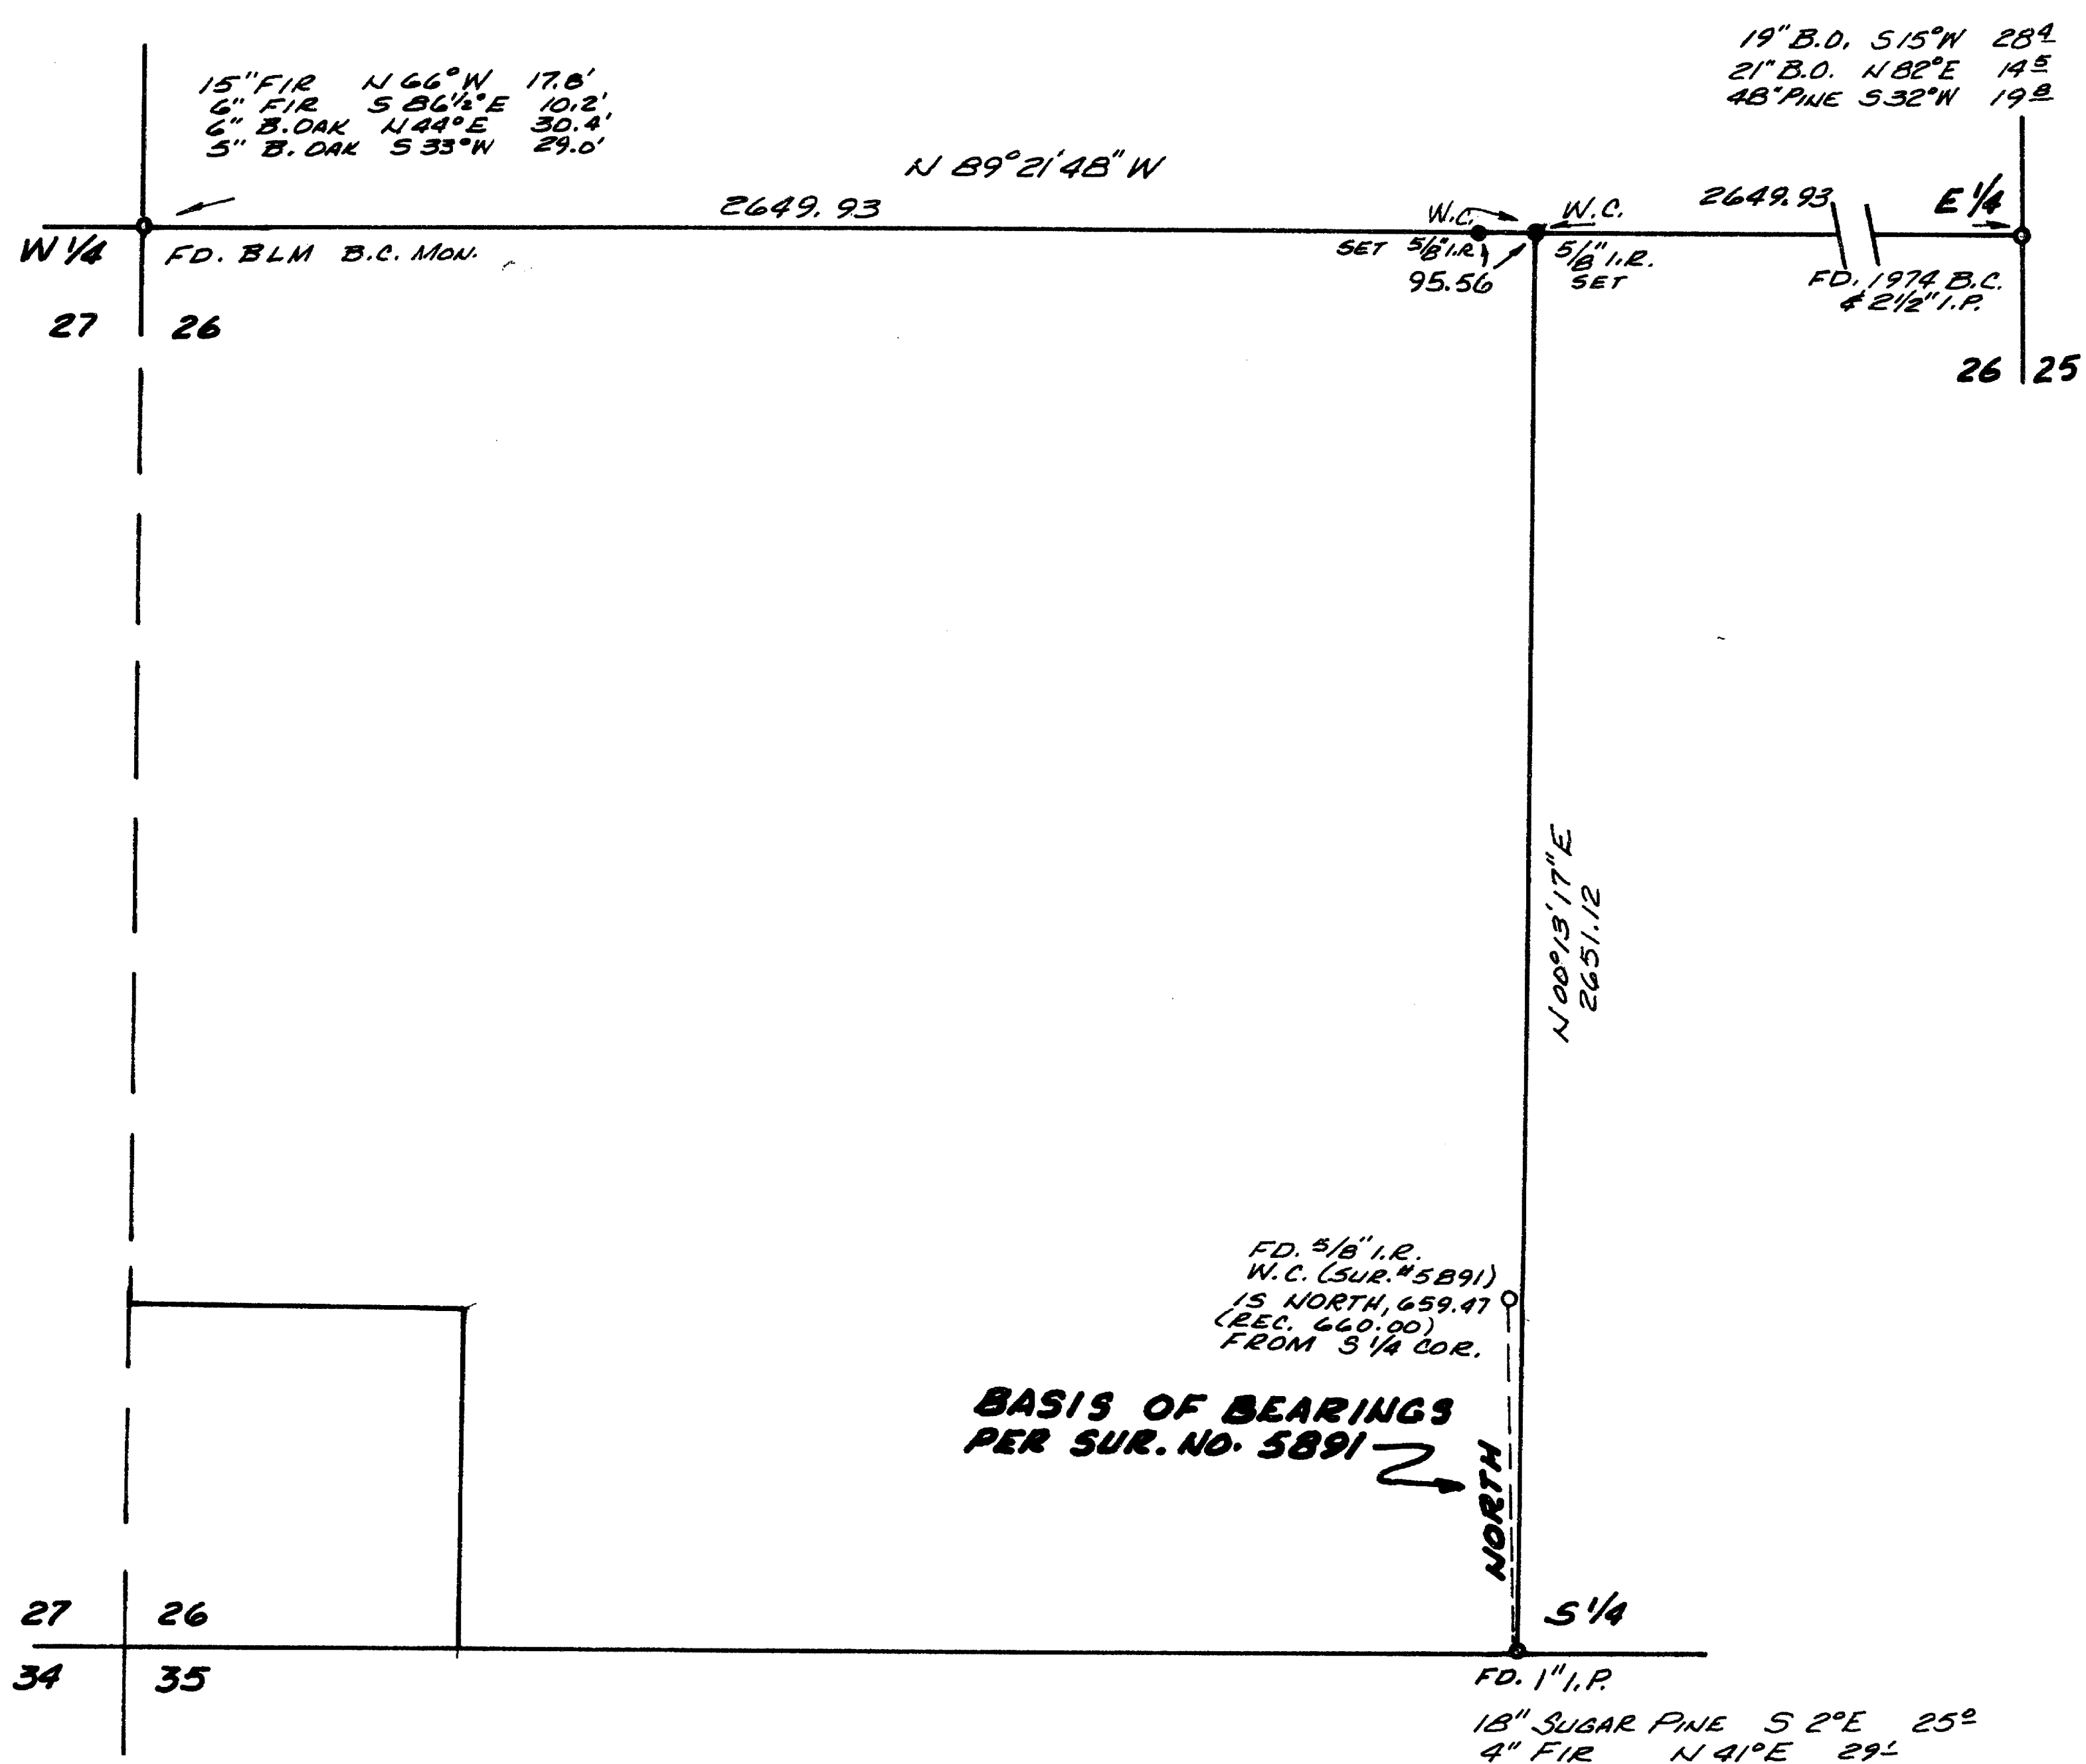

NARRATIVE:


Purpose of Survey: To determine the North line of the Southwest Quarter of Sec. 26 and the approximate position of the East line of the Southwest Quarter.

Procedure: Ran an open traverse from the S 1/4 corner to the E 1/4 corner and to the W 1/4 corner. Set a Witness corner at Midpoint of E-W centerline and a second W.C. N 89° 21' 48" W, 95.56 feet of said Midpoint.

REGISTERED
PROFESSIONAL
LAND SURVEYOR

Robert Mason

OREGON
JULY 22, 1974
ROBERT MASON
1011

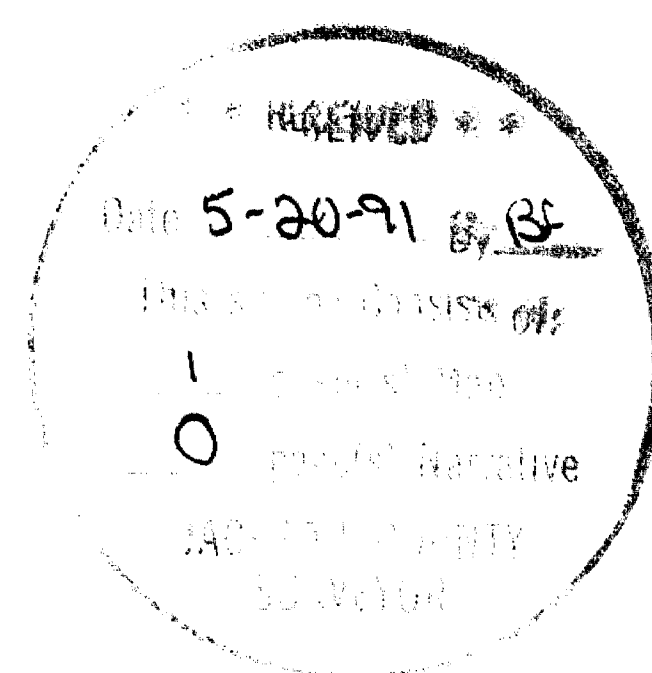

12520