

12522

Survey for:

Date: May 15, 1991

Steve Roberts
P. O. Box 28
Prospect, Oregon
97536

Survey by:

Kaiser Surveying
108 Mistletoe St.
Medford, Oregon
97501

Location:

SE 1/4 of Section
27, T.32S., R.2E., W.M.
Jackson County, Or.

Basis of Bearings

Filed Survey
No. 10091




NORTH
Scale: 1" = 200'

REGISTERED
PROFESSIONAL
LAND SURVEYOR

G. D. Kaiser

OREGON
JULY 16, 1987
GARY D. KAISER
No. 803

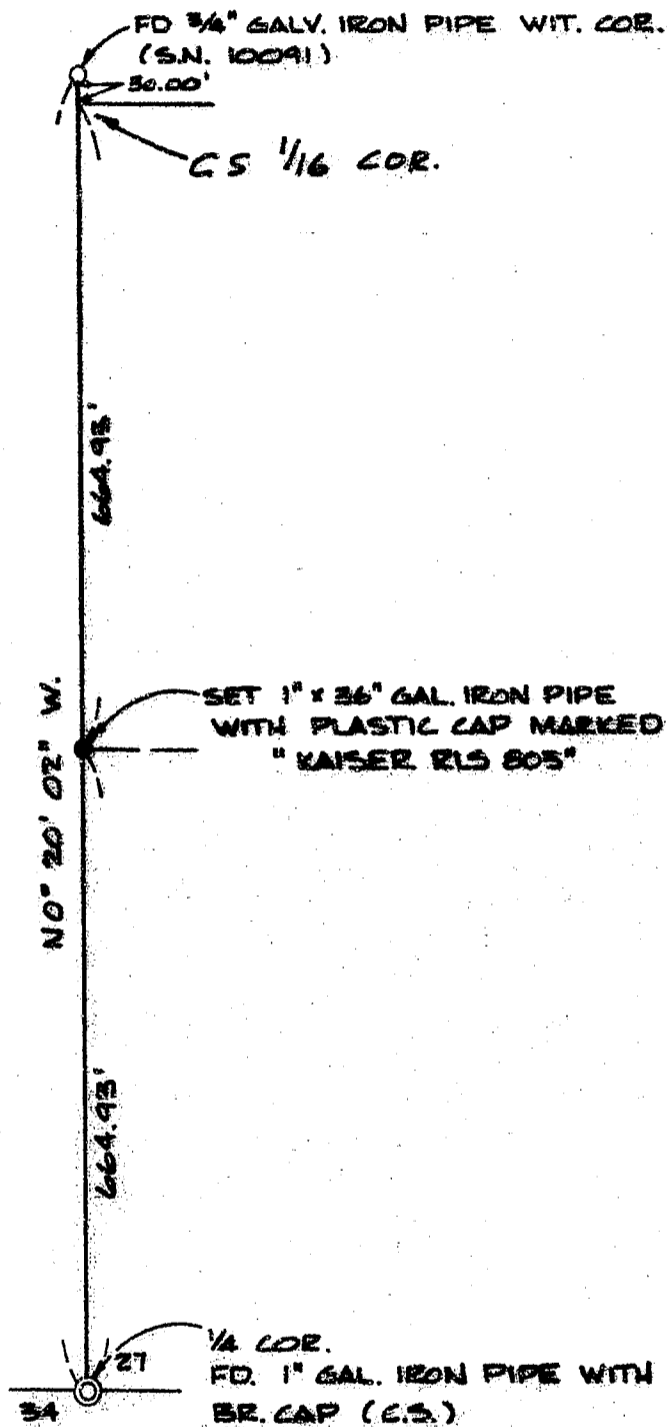

5-22-91 By GC
This survey consists of:
— sheet(s) Map
— page(s) Narrative
JACKSON COUNTY
SURVEYOR

Tax Lot No. 7406 -32 -2E -27 /

12522

GARY D. KAISER
R.P.L.S. ORE. 803
C.W.R.E. ORE. 73

KAISER SURVEYING
108 MISTLETOE STREET
MEDFORD, OREGON 97501

PHONE
MEDFORD (503) 779-8040
SHADY COVE (503) 878-3995

SURVEY NO. 12522

SURVEY NARRATIVE TO COMPLY WITH O.R.S. 209.250

SURVEY FOR: STEVEN E. ROBERTS
P. O. BOX 28
PROSPECT, OREGON 97536

SURVEY BY: KAISER SURVEYING
108 MISTLETOE STREET
MEDFORD, OREGON 97501


LOCATION: SE ¼ OF SECTION 27,
T. 32 S., R. 2 E., W.M.
JACKSON COUNTY, OREGON

BASIS OF BEARINGS: FILED SURVEY NO. 10091

DATE: MAY 15, 1991

PURPOSE: To monument the C-S-CS 1/64 corner
to Section 27.

PROCEDURE: Traversed from South Quarter corner
to Section 27 to the witness corner set 30 feet North of the
CS 1/16 corner and set the desired 1/64 corner as shown on
the annexed map.

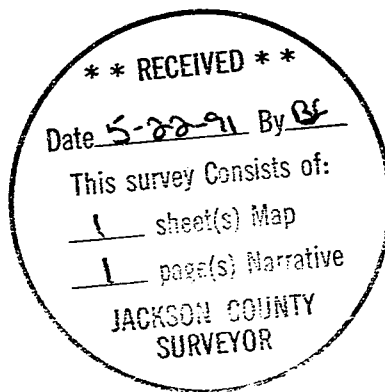

G. D. Kaiser

