


12635

12635

TOWNSHIP 40 SOUTH, RANGE 01 WEST, W.M.
SECTION 14
JACKSON COUNTY, OREGON

SURVEY FOR: MEDFORD CORPORATION
P.O. BOX 550
MEDFORD, OREGON 97501

SURVEY BY: JAMES ARTMAN SURVEYING
P.O. BOX 576
WINSTON, OREGON 97496
(503) 679-7176

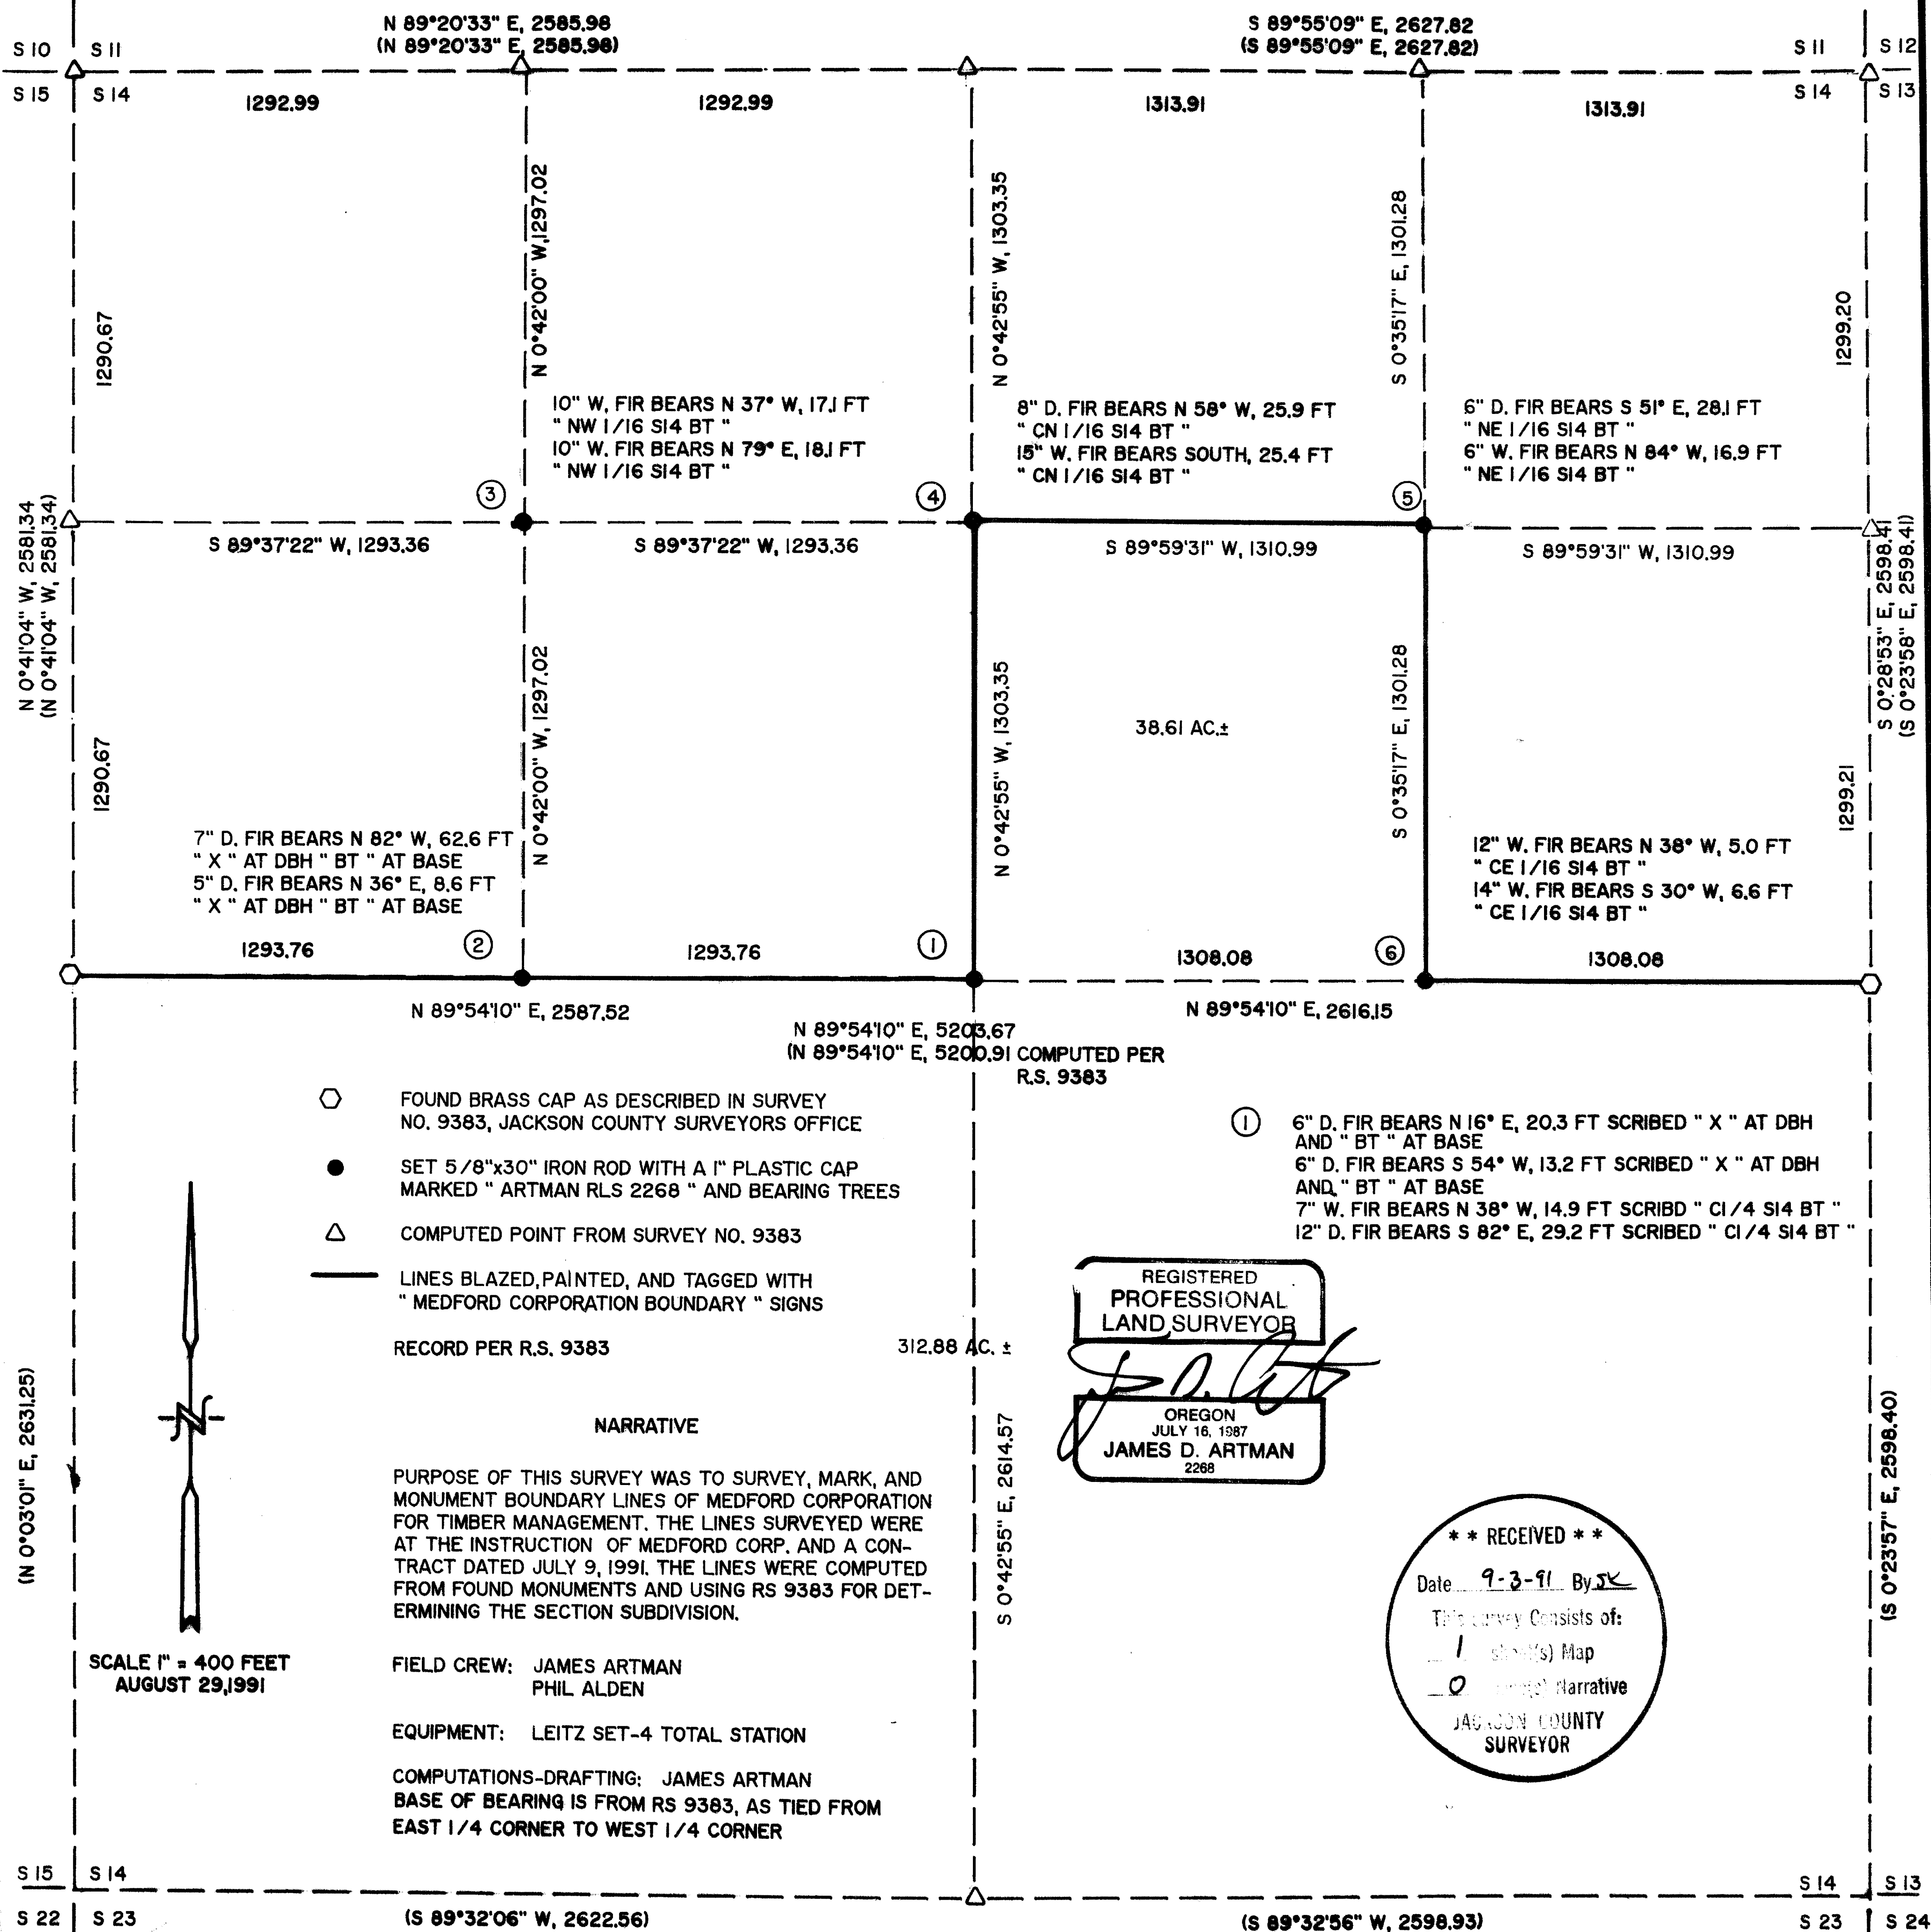

SCALE 1" = 400 FEET
AUGUST 29, 1991

12635

12635