

12653

PLAT OF SURVEY


LOCATED in the NE 1/4 of Sec. 11, T.33S., R.2E., W.M.
Jackson County, Oregon
August 14, 1991

**** RECEIVED ****
 Date 9-13-91 By BE
 This survey Consists of:
1 sheet(s) Map
1 page(s) Narrative
 JACKSON COUNTY
 SURVEYOR

SURVEYED FOR: Gail Homalka
16 Valley View
Irvine, CA. 92715

SURVEYED BY: Edwards Surveying and Land Planning Inc.
823 W. 8th Street
Medford, Oregon 97501
Phone: (503) 776-2313

**REGISTERED
 PROFESSIONAL
 LAND SURVEYOR**
David A. Edwards
 OREGON
 JULY 26, 1990
DAVID A. EDWARDS
 2339

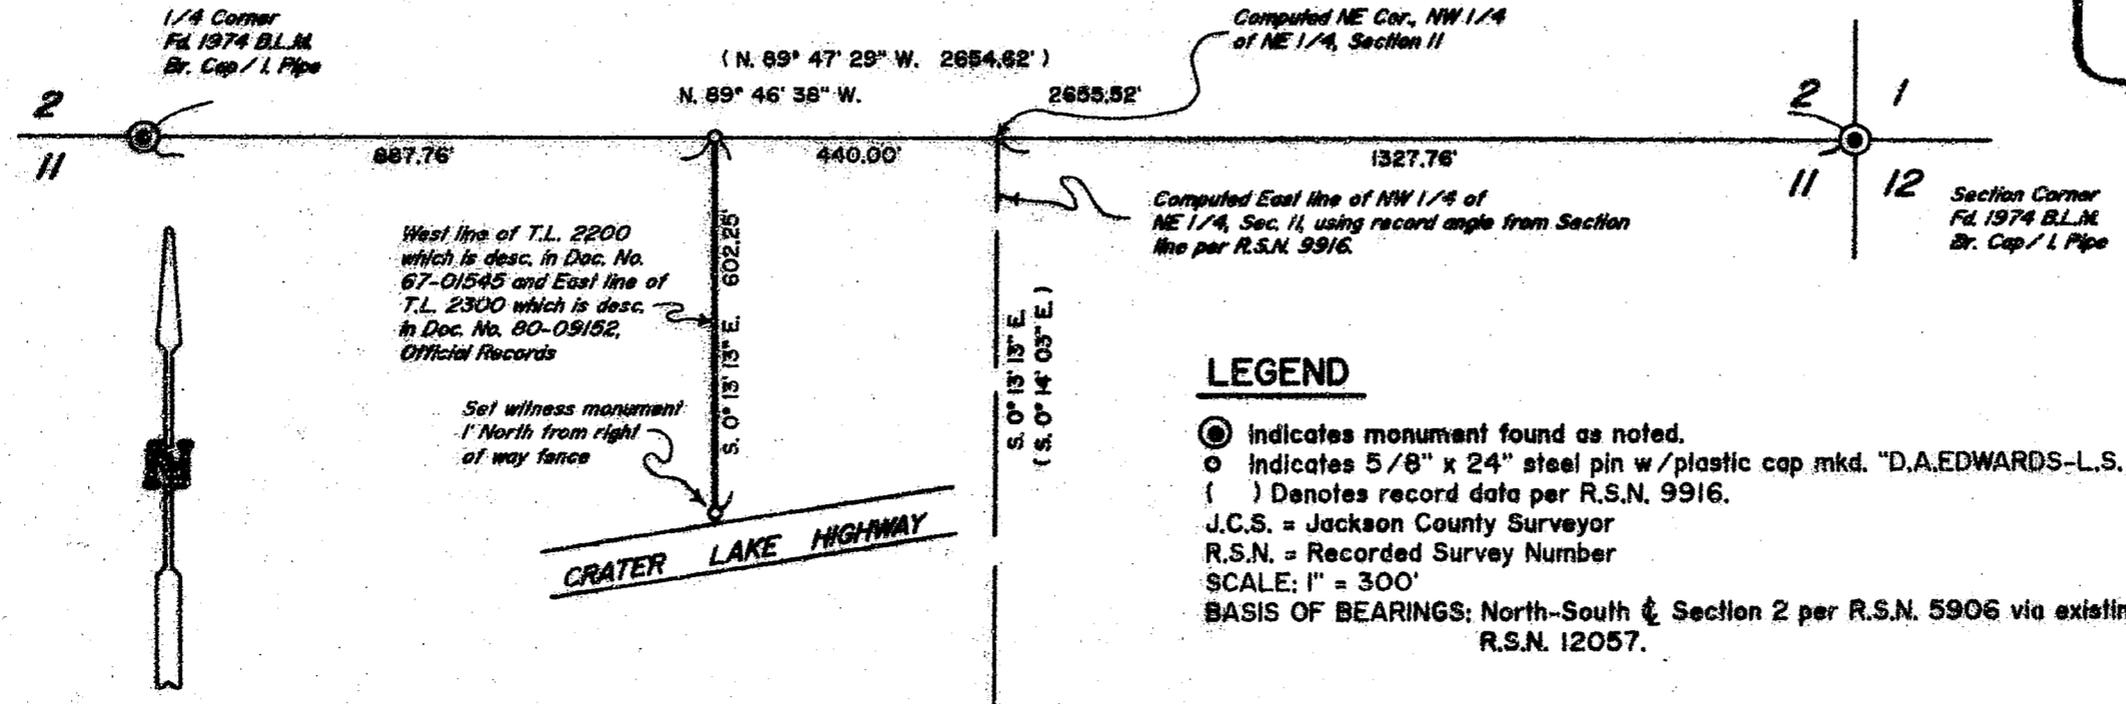

LEGEND

- ⊙ indicates monument found as noted.
- indicates 5/8" x 24" steel pin w/ plastic cap mkd. "D.A. EDWARDS-L.S. 2339" set.
- () Denotes record data per R.S.N. 9916.
- J.C.S. = Jackson County Surveyor
- R.S.N. = Recorded Survey Number
- SCALE: 1" = 300'
- BASIS OF BEARINGS: North-South & Section 2 per R.S.N. 5906 via existing control on R.S.N. 12057.

T33-2E-11 Tax Lots 2200 & 2300

12653

Edwards Surveying & Land Planning Inc.

DARREL W. EDWARDS
OREGON REG. 741
ARIZONA REG. 9746



DAVID A. EDWARDS
OREGON REG. 2339

REGISTERED LAND SURVEYORS
823 WEST 8TH ST.
MEDFORD, OREGON 97501
(503) 776-2313 • (503) 471-7059

SURVEY NUMBER 12653

SURVEY NARRATIVE TO COMPLY WITH CHAPTER 209, PARAGRAPH 250,
OREGON REVISED STATUTES

SURVEY FOR: Gail Homolka
16 Valley View
Irvine, California 92715

LOCATION: In the NE 1/4 of Section 11, T. 33 S.,
R. 2 E., W.M., Jackson County, Oregon.


PURPOSE: To locate and monument the West line of tract
described in Doc. No. 67-01545, Official
Records, being also the East line of tract
described in Doc. No. 80-09152, as shown
on the accompanying plat.

PROCEDURE: Utilizing existing control points and data
established during the execution of Recorded
Survey Number 12057, as well as data found in
the above noted deeds and in R.S.N. 9916,
computed the location of the line in question.
Monuments set on this survey consist of 5/8" x
24" steel pins with red plastic caps mkd.
"D.A. EDWARDS-RPLS 2339".

**BASIS OF
BEARINGS:** North-South center line of Section 2 per R.S.N.
5906 via existing control per R.S.N. 12057.

EQUIPMENT: Nikon NTD-4 Semi-automatic theodolite/E.D.M.

**DATE
COMPLETED:** August 14, 1991

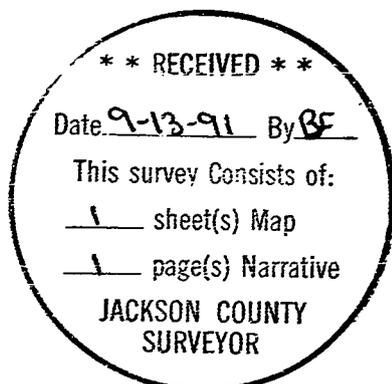

REGISTERED
PROFESSIONAL
LAND SURVEYOR

David A. Edwards

OREGON
JULY 26, 1990
DAVID A. EDWARDS
2339