


BEARINGS FROM PREVIOUS SURVEY

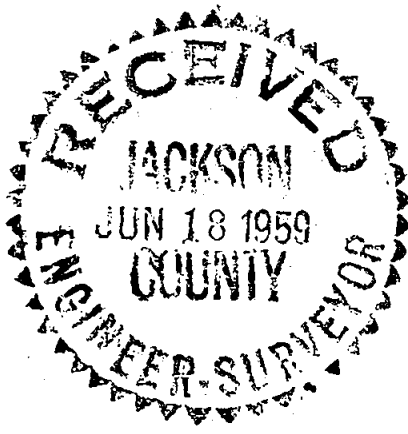

REGISTERED
OREGON
 LAND SURVEYOR

Leland P. Lovejoy

NOVEMBER 18 1948
LELAND P. LOVEJOY
 282

BOUNDARY SURVEY
PROPERTY SITUATE
SEC 1, T37S R2W W.M.
JACKSON COUNTY OREGON
L.P. LOVEJOY LAND SURVEYOR
MEDFORD, ORE. APRIL 21, 1958
SCALE 1" = 100'

Survey Narrative to Comply with Section 87-3301947 Oregon State Laws

Survey for: Chris Barker
48 Hawthorne Avenue
Medford, Oregon

Purpose of Survey: To subdivide a parcel of land.

Survey Location: Section 1, Township 37 South, Range 2
West, Willamette Meridian, Jackson
County, Oregon.

Survey Procedure: Found survey monuments as indicated
on map. Set 3/4" galvanized iron pipes.
Bearings from previous survey.

Leland P. Lovejoy
Registered Land Surveyor
Work completed May 15, 1958

