


RECORD BEARINGS USED

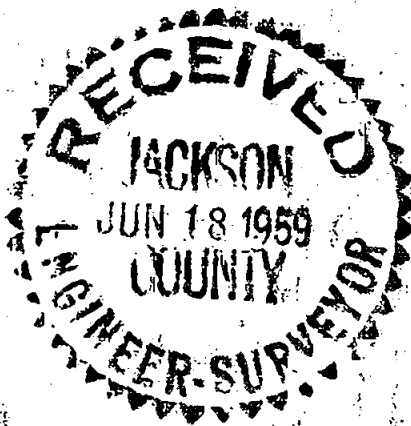

REGISTERED
OREGON
 LAND SURVEYOR

Leland P. Lovejoy

NOVEMBER 8, 1940
LELAND P. LOVEJOY
 262

BOUNDARY SURVEY

SITUATE
 D.L.C. #60 T37S R2W WM
 JACKSON COUNTY, OREGON
 L.P. LOVEJOY L. S. MEDFORD, OREGON
 SCALE: 1"=100' MAY 11, 1959

Survey Narrative to Comply with Section 87-3301947 Oregon State Laws

Survey for: G. W. McBee
Table Rock Road
Medford, Oregon

Purpose of Survey: To establish boundaries of property to
be retained out of large tract.

Survey Location: D. L. C. 60, Township 37 South, Range 2
West, Willamette Meridian, Jackson
County, Oregon

Survey Procedure: Found corner and other survey monuments
as indicated on map, which was used for
basis of survey control. Set 5/8" steel pins.
Record bearings used.

Leland P. Lovejoy
Registered Land Surveyor
Work completed June 15, 1959

