

1279  
6281

Survey Narrative to Comply with Section 87-3301947 Oregon State Laws


Survey for: Everett M. Young  
Willow Springs Road  
Central Point, Oregon

Purpose of Survey: To establish property boundaries

Survey Location: D. L. C. 64, Township 36 South, Range 2  
West, Willamette Meridian, Jackson  
County, Oregon.

Survey Procedure: Found corner monuments as indicated on  
map. Set 3/4" galvanized iron pipes.  
Bearings by previous survey.

Leland P. Lovejoy  
Registered Land Surveyor  
Work completed January 10, 1959

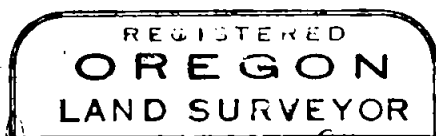

*Leland P. Lovejoy*

