


BEARINGS BY SOLAR OBSERVATION

REGISTERED  
OREGON  
LAND SURVEYOR

*Leland P. Lovejoy*

NOVEMBER 18 1949  
LELAND P. LOVEJOY  
202

BOUNDARY SURVEY  
SITUATE IN  
SE. 1/4, SEC. 36, T.36S, R.2W.W.M.  
JACKSON COUNTY OREGON  
L.P. LOVEJOY LS. MEDFORD, ORE.  
SCALE 1"=100' DEC. 12, 1958

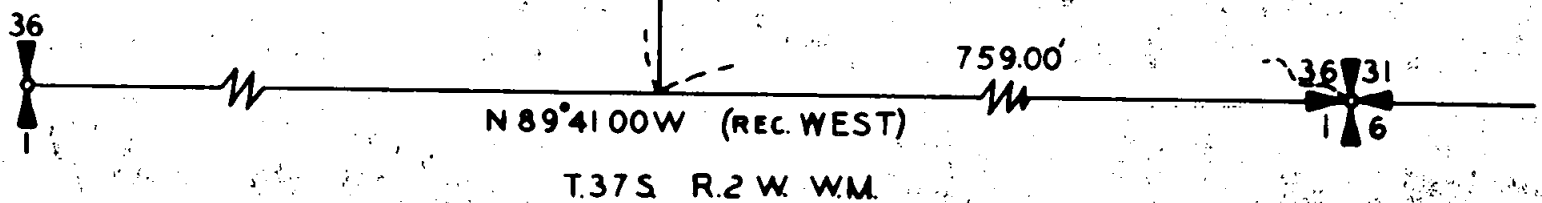

T.36S. R.2 W. W.M.

T.37S R.2 W. W.M.

Survey Narrative to Comply with Section 87-3301947 Oregon State Laws


Survey for: Loyd E. Jones  
East Vilas Road  
Central Point, Oregon

Purpose of Survey: To establish property boundaries

Survey Location: Southeast Quarter (1/4) Section 36,  
Township 36 South, Range 2 West,  
Willamette Meridian, Jackson  
County, Oregon.

Survey Procedure: Found corner monuments as indicated  
on map. Ran out property boundaries  
as described in Deed Record. "Set 3/4"  
galvanized iron pipes. Bearings by  
solar observations.

Leland P. Lovejoy  
Registered Land Surveyor  
Work completed December 29, 1958

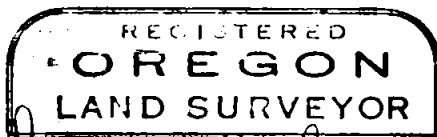

*Leland P. Lovejoy*

 A rectangular stamp with rounded corners, containing the text: "NOVEMBER 18, 1949 LELAND P. LOVEJOY 262". The signature "Leland P. Lovejoy" is written over the stamp.
