

BOUNDARY SURVEY
 SITUATE IN
 NE 1/4, SEC. 8, T.37S, R.2W.WM.
 JACKSON COUNTY OREGON
 L.P. LOVEJOY, LS. MEDFORD, ORE.
 SCALE 1"=50' DEC.17, 1958

REGISTERED
OREGON
 LAND SURVEYOR
Leland P. Lovejoy
 NOVEMBER 18, 1949
LELAND P. LOVEJOY,
 282

RECEIVED
 JACKSON
 JUN 18 1959
 COUNTY
 ENGINEER-SURVEYOR

BEARINGS BY PREVIOUS SURVEY

WEST 268.30'
 1/4 COR. (FOUND)

Survey Narrative to Comply with Section 87-330

1947 Oregon State Laws



Survey for: W. J. Williams
831 Park
Medford, Oregon

Purpose of Survey: To subdivide tract of land into two parcels.

Survey Location: Northeast Quarter (1/4) Section 8,
Township 37 South, Range 2 West,
Willamette Meridian, Jackson County,
Oregon.

Survey Procedure: Found corner monument as indicated on
map. Ran out property boundaries as
described in Deed Record. Set 3/4"
galvanized iron pipes. Bearings from
previous survey.

Leland P. Lovejoy
Registered Land Surveyor
Work completed January 19, 1959

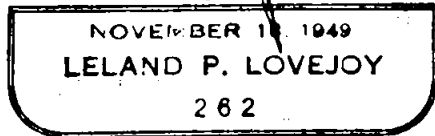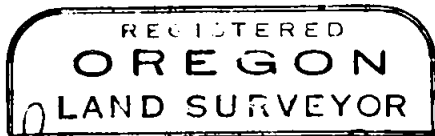

Leland P. Lovejoy

