

## MAP OF SURVEY

LOCATED in the NW 1/4 of Section 17, T. 36 S., R. 3 W., W.M., in Jackson County, Oregon.

February 10, 1992

SURVEYED FOR: Foley Roads Inc.

c/o Stan Foley P.O. Box 3636

Central Point, OR 97502

SURVEYED BY: Edwards Surveying and Land Planning Inc.

823 W. 8th Street Medford, Oregon 9750/

Phone: (503) 776-23/3

REGISTERED PROFESSIONAL LAND SURVEYOR Varid a. Edwards OREGON
JULY 26, 1988
DAVID A EDWARDS

## LEGEND

- Indicates monument found as noted.
- O Indicates 5/8" x 30" steel pin w/red plastic cap mkd."D.A. EDWARDS-LS 2339" set.
- ( ) Denotes original Gov't. survey record data unless noted otherwise.

x-x-x-x Fence Line


R.S.N. = Recorded Survey Number

SCALE: I" = 500'

J.C.S. = Jackson County Surveyor

BASIS OF BEARINGS: East line of Section 17 per R.S.N. 8381.

\* \* RECEIVED \* \* Dete 3-12-92 By CF This survey Consists of: \_\_\_ sheet(s Map parn(s) "larratine MCKED'S COMMIN

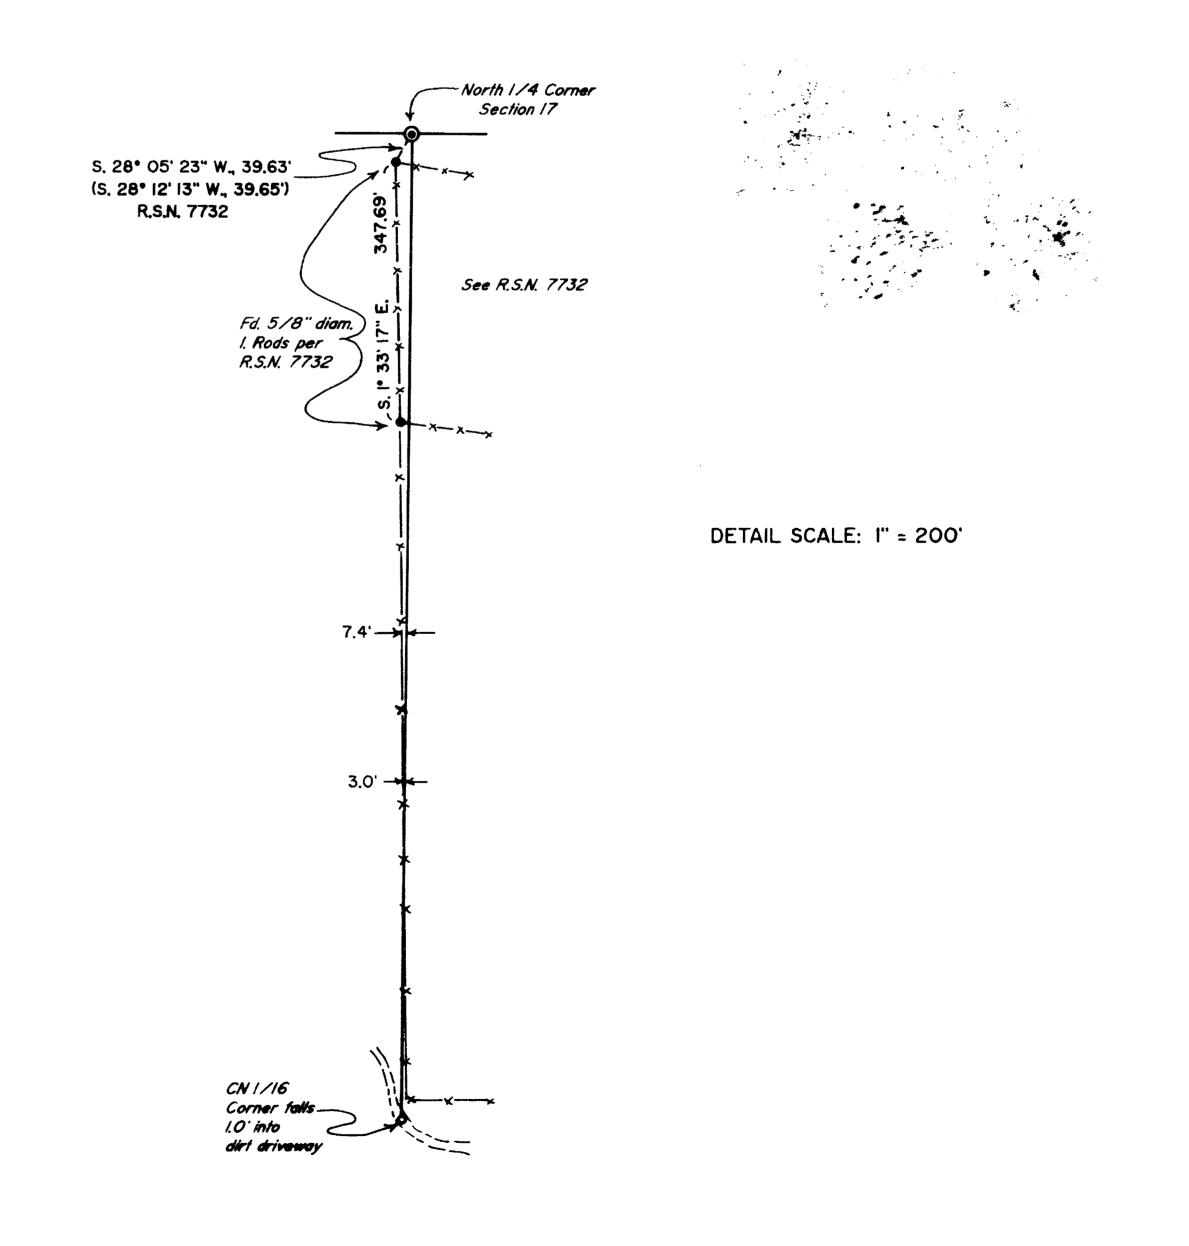

## Edwards Surveying & Land Planning Inc.

Darrel W. Edwards OREGON REG. 741 ARIZONA REG. 9746



DAVID A. EDWARDS OREGON REG. 2339

REGISTERED LAND SURVEYORS 823 WEST 8TH ST. MEDFORD, OREGON 97501 (503) 776-2313 • (503) 471-7059

SURVEY NUMBER 12891

SURVEY NARRATIVE TO COMPLY WITH CHAPTER 209, PARAGRAPH 250, OREGON REVISED STATUTES

SURVEY FOR:

Foley Roads Inc.

P.O. Box 3636

Central Point, Oregon 97502

LOCATION:

In the NW 1/4 of Section 17, T. 36 S., R. 3 W., W.M., Jackson County, Oregon.

**PURPOSE:** 

To locate and monument the boundaries of the NE 1/4 of the NW 1/4 of Section 17, as shown on

the accompanying map.

PROCEDURE:

A control traverse was executed which tied in all controlling government corners as shown. A search for the East 1/4 corner had been made previously by this office and the County Surveyor's office. No trace of the original corner was ever found. After computing the subdivision of Section 17 from the current ties, a search was made for the West 1/4 corner by the County and this office, with negative results. Therefore I use the proportionate positions as shown. Bearing trees established on this survey are scribed according to the 1973 B.L.M. Manual, measured to center of tree at root crown, and are situated as follows: At the CN 1/16 corner:

A 20" diam. W. Oak brs. S.57°17'E., 60.16 feet. A 16" diam. Pine bears S.87°59'W., 42.63 feet.

\* \* RECEIVED \* \*

Date 3-12-92 By 35 This survey Consists of:

JACKSON COUNTY SURVEYOR

At the NW 1/16 corner:

diam Madrone brs. N.23°04'E., 18.47 feet. A 12" A 14" diam. W. Oak brs. S.61009'E., 7.01 feet.

At the West 1/16 corner on the North line: A 5" diam. Madrone brs. N. 1° E., 1.76 feet. A 6" diam. Madrone brs. S. 86° W., 7.20 feet.

Monuments set on this survey consist of 5/8" x30" steel pins with red plastic caps mkd. "D.A. EDWARDS-LS 2339".

BASIS OF **BEARINGS:** 

East line of Sec. 17 per R.S.N. 8381.

EQUIPMENT:

Nikon NTD-4 Semi-automatic theodolite/E.D.M.

DATE

COMPLETED:

February 10, 1992.

REGISTERED PROFESSIONAL LAND SURVEYOR

Yavid a. Edward OREGON JULY 26, 1988 DAVID A EDWARDS 2339