

LEGEND

- FD. JACKSON COUNTY BRASS CAP, PER RE-ESTABLISHMENT BOOK, PAGE 71
- ⊗ FD. JACKSON COUNTY BRASS CAP, PER RE-ESTABLISHMENT BOOK, PAGE 23
- ⊙ FD. JACKSON COUNTY BRASS CAP, PER RE-ESTABLISHMENT BOOK, PAGE 26
- FD. JACKSON COUNTY BRASS CAP, PER RE-ESTABLISHMENT BOOK, PAGE 27
- ☑ FD. JACKSON COUNTY BRASS CAP, PER RE-ESTABLISHMENT BOOK, PAGE 53
- SET 5/8" x 30" REBAR WITH YELLOW PLASTIC CAP MARKED "TEMPLIN LS2359"
- ⊙ SET 1" x 30" GALV. IRON PIPE WITH YELLOW PLASTIC CAP IN TOP MARKED "TEMPLIN LS 2359 "
- INDICATES LINES BLAZED AND PAINTED

•• RECEIVED ••
 Date 4-3-92 by *RF*
 This plat consists of:
 1
 2
 JACSON COUNTY SURVEYOR

BASIS OF BEARING BASED ON SOLAR OBSERVATION

REGISTERED PROFESSIONAL LAND SURVEYOR
Richard G. Templin
 OREGON
 RICHARD G. TEMPLIN
 2359

RICHARD TEMPLIN LAND SURVEYING
 2042 SANDRA PL 776-0991 & 474-7720 MEDFORD, OREGON

PLAT OF SURVEY

LOCATED IN
 SECTION 36, T.35S., R.4W., W.M.
 JACKSON COUNTY, OREGON

SURVEYED FOR: MEDFORD CORPORATION P.O. BOX 550 MEDFORD, OREGON
 DATE: MARCH 23, 1992

RICHARD G. TEMPLIN
PROFESSIONAL LAND SURVEYOR

12933

2042 Sandra Pl.
Medford, Oregon 97504
(503) 776-0991 • 474-7720

I then returned to the C 1/4 corner and ran S 89°34'23" E, 1297.59 feet to the CE 1/16 corner, at said CE 1/16 corner set:

A 1"x 30" iron pipe with yellow plastic cap marked, "TEMPLIN LS 2359", from which scribed the following bearing tree:

A Cedar, 8" diameter bears S 22°E, 7.4 feet, scribed " CE 1/16S36" "BT".



A Madrone, 13" diameter bears N 76°W, 13.0 feet, scribed " CE 1/16S36" "BT".

I then ran N 00°05'52" E, 2637.21 feet to the E 1/16 corner between Section 25 and 36, at said E 1/16 corner set:


A 5/8"x 30" rebar with yellow plastic cap marked, "TEMPLIN LS 2359", from which scribed the following bearing tree:

A Douglas Fir, 13" diameter bears S 19°W, 12.0 feet, scribed " E1/16S36" "BT".

A Douglas Fir, 6" diameter bears N 61°W, 8.6 feet, scribed " E1/16S25" "BT".

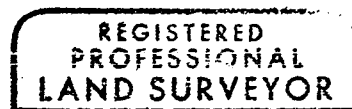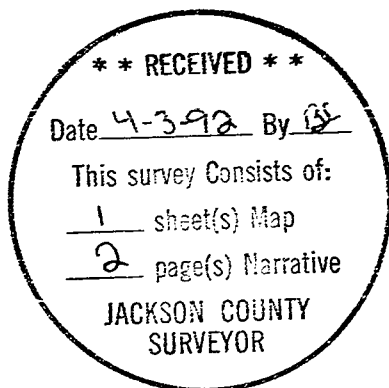

Richard G. Templin

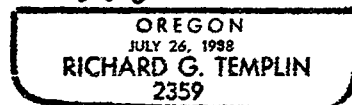

RICHARD G. TEMPLIN
PROFESSIONAL LAND SURVEYOR
2042 Sandra Pl.
Medford, Oregon 97504
(503) 776-0991 • 474-7720

NARRATIVE

Survey No. 12933

SURVEY FOR: Medco Corporation
P.O. Box 550
Medford, Oregon 97501

LOCATION: Section 36, Township 35 South, Range 4 West, of
the Willamette Meridian, Jackson County, Oregon.

PURPOSE: To run and mark true line as shown on
accompanying plat.

DATE: March 23, 1992

BASIS OF BEARING: Bearings based upon Solar Observation.

PROCEDURE Tied the North, South, East and West Quarter
corners, along with the NE corner of Section 36.
Computed the C 1/4 corner position from control
traverse and at said C 1/4 set:

A 1"x 30" iron pipe with yellow plastic cap
marked, "TEMPLIN LS 2359", from which scribed the
following bearing tree:
A Black Oak, 8" diameter bears N 5°E, 10.6 feet,
scribed " C1/4S36" "BT".
A Douglas Fir, 6" diameter bears N 38°E, 21.0
feet, scribed " C1/4S36" "BT".
A Douglas Fir, 12" diameter bears S 37°E, 20.4
feet, scribed " C1/4S36" "BT".
A Black Oak, 5" diameter bears S 12°W, 21.7 feet,
scribed " C1/4S36" "BT".

I then ran true line S 00°20'28" E, 2678.00 feet
to the S 1/4 of Section 36, which was blazed and
painted red.