

LEGEND

- FD. BRASS CAP PER JACKSON COUNTY RE-ESTABLISHMENT BOOK, PAGE 23
- FD. BRASS CAP PER JACKSON COUNTY RE-ESTABLISHMENT BOOK, PAGE 22
- FD. BRASS CAP PER JACKSON COUNTY RE-ESTABLISHMENT BOOK, PAGE 108
- FD. BRASS CAP PER ~~MLM~~ BOOK, PAGE 36
- FD. BRASS CAP PER JACKSON COUNTY RE-ESTABLISHMENT BOOK, PAGE 26
- FD. 5/8" IRON ROD WITH YELLOW PLASTIC CAP MARKED "TEMPLIN LS2359"
- SET 5/8" x 30" REBAR WITH YELLOW PLASTIC CAP MARKED "TEMPLIN LS2359"

BEARINGS BASED ON SOLAR OBSERVATION

**\*\* RECEIVED \*\***  
 Date 4-9-92 By RF  
 This survey consists of:  
 1. (1) Map  
 2. (2) Narrative  
 JACKSON COUNTY SURVEYOR

REGISTERED PROFESSIONAL LAND SURVEYOR  
*Richard G. Templin*  
 OREGON  
 JULY 26, 1988  
 RICHARD G. TEMPLIN  
 2359

RICHARD TEMPLIN LAND SURVEYING  
 2042 SANDRA PL 776-0991 & 474-7720 MEDFORD, OREGON  
**MAP OF SURVEY**  
 LOCATED IN  
 SECTION 25, T.35S., R.4W., W.M.  
 JACKSON COUNTY, OREGON  
 SURVEYED FOR: MEDFORD CORPORATION P.O. BOX 550 MEDFORD, OREGON  
 DATE: APRIL 4, 1992

**RICHARD G. TEMPLIN**  
PROFESSIONAL LAND SURVEYOR

2042 Sandra Pl.  
Medford, Oregon 97504  
(503) 776-0991 • 474-7720

12940

I then ran S 89°06'00" E, 1314.48 feet to the S 1/16 corner between Section 25 and 30. At said corner set:

A 5/8"x 30" rebar with yellow plastic cap marked, "TEMPLIN LS 2359", from which scribed the following bearing tree:


A Douglas Fir, 18" diameter bears S 34°W, 18.0 feet, scribed " S1/6S25" "BT".

A Madrone, 12" diameter bears N 35°W, 14.3 feet, scribed " SE1/16S25" "BT".

I then ran N 00°02'23" E, 1316.06 feet from said S 1/16 corner between Section 25 and 30 to the E 1/4 of Section 25 to check.

Returning to the C 1/4 of Section 25, I ran S 89°18'43" East, 2621.67 feet to the East 1/4 of Section 25 and N 00°21'16" East, 2620.63 feet to check.

All lines ran were blazed and painted red.

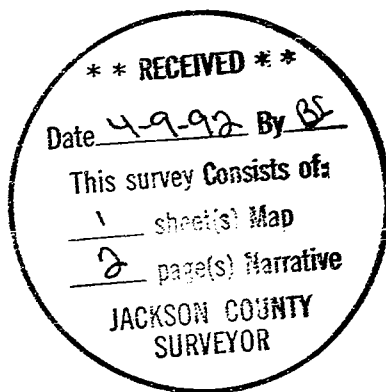

**RICHARD G. TEMPLIN**  
PROFESSIONAL LAND SURVEYOR

2042 Sandra Pl.  
Medford, Oregon 97504  
(503) 776-0991 • 474-7720

NARRATIVE

Survey No. 12940

SURVEY FOR: Medco Corporation  
P.O. Box 550  
Medford, Oregon 97501

LOCATION: Section 25, Township 35 South, Range 4 West, of  
the Willamette Meridian, Jackson County, Oregon.

PURPOSE: To run and mark true line as shown on  
accompanying plat.

DATE: April 8, 1992

BASIS OF BEARING: Bearings based upon Solar Observation.

PROCEDURE Tied the North, South, East and West Quarter  
corners, along with the SE corner of Section 25.  
Computed the C 1/4 corner position from control  
traverse and at said C 1/4 set:

A 5/8"x 30" rebar with yellow plastic cap marked,  
"TEMPLIN LS 2359" in top of sawed 30" Madrone  
stump, from which scribed the following bearing  
tree:

- A Cedar, 4" diameter bears N 26°E, 22.9 feet,  
scribed " C1/4S25" "BT".
- A Douglas Fir, 7" diameter bears S 17°E, 16.5  
feet, scribed " C1/4S25" "BT".
- A Douglas Fir, 12" diameter bears S 68°W, 33.1  
feet, scribed " C1/4S25" "BT".
- A Douglas Fir, 6" diameter bears N 36°E, 25.3  
feet, scribed " C1/4S25" "BT".

I then ran N 00°11'47" E, 1311.17 feet from the  
E 1/16 corner between Section 25 and 36, set by  
me on previous survey subdividing Section 36, to  
the SE 1/16 corner of Section 25. At said corner  
set:

- A 5/8"x 30" rebar with yellow plastic cap marked,  
"TEMPLIN LS 2359", from which scribed the  
following bearing tree:
- A Ponderosa Pine, 10" diameter bears N 50°E, 11.8  
feet, scribed " SE1/6S25" "BT".
- A Ponderosa Pine, 18" diameter bears S 21°E, 10.3  
feet, scribed " SE1/16S25" "BT".