


MAP OF SURVEY

A portion of the N.W. 1/4 of Sec. 9, T.35 S.,
R.2 W., W.M. Jackson County, Oregon.

13079

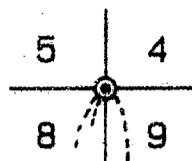

SURVEY FOR:

Cleo Taylor
P.O. Box 206
Rogue River, OR 97537

SURVEY BY:

L.J. Friar & Associates, P.C.
Consulting Land Surveyors
304 South Holly Street
Medford, Oregon 97501
Phone: (503) 772-2782


LEGEND:

- ⊙ - Found County Surveyor's Brass capped monument and accessories per re-estab's.
- - Set 5/8" x 30" iron pin with plastic cap mkd. L.J. FRIAR & ASSOCIATES.
- () - Record data per S.L.O Survey.

BASIS OF BEARINGS: Survey No. 12173.

DATE: June 30, 1992

SCALE: 1" = 500'

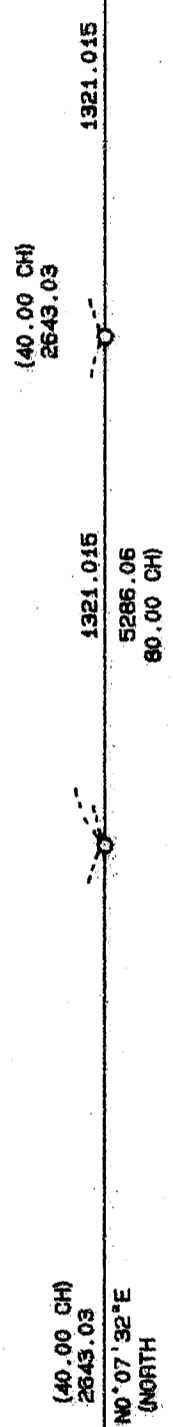

REGISTERED
PROFESSIONAL
LAND SURVEYOR

James E. Hibbs

OREGON
JULY 17, 1986
JAMES E. HIBBS
2234

** RECEIVED **

Date 7-17-92 By JL

This survey Consists of:

1 sheet(s) Map

1 page(s) Narrative

JACKSON COUNTY
SURVEYOR

13079

352W09 TL100 ✓

SURVEY NO. 13079

SURVEY NARRATIVE TO COMPLY WITH O.R.S. 209.250

SURVEY FOR: Cleo Taylor
P.O. Box 206
Rogue River, OR 97537

LOCATION: The West half of Section 9, T.35 S., R.2 W., W.M.,
Jackson County, Oregon.

PURPOSE: To monument to West one-quarter corner and the
North one-sixteenth corner on the West line of
Section 9.

PROCEDURE: From control established in the area by this office
during Survey No. 12173, monumented the corners at
proportionate distance as shown on the attached map
and took accessories as follows:

At the West one-quarter corner of Section 9, set
5/8" x 30" iron pin with plastic cap marked L.J.
FRIAR & ASSOCIATES from which:

A 5" B. Oak brs. N.16°E., 12.2 ft., mkd. 1/4S9BT.
A 15" Laurel brs. S.19°E., 19.3 ft., mkd. 1/4S9BT.
A 4" B. Oak brs. S.22°W., 9.1 ft., mkd. 1/4S8BT.
A 10" Laurel brs. N.24°W., 10.7 ft., mkd. 1/4S8BT.

At the North one-sixteenth corner on the West line
of Section 9, set 5/8" x 30" iron pin with plastic
cap marked L.J. FRIAR & ASSOCIATES from which:

An 8" W. Oak brs. S.89°E., 52.7 ft., mkd. N1/16S9BT.
A 12" W. Oak brs. N.07°W., 28.7 ft., mkd. N1/16S8BT.

BASIS OF BEARING: Survey No. 12173.

DATE: June 29, 1992

T35S R2W SEC09 TL100

James E. Hibbs, PLS 2234
L.J. Friar & Associates P.C.
Consulting Land Surveyors
304 South Holly Street
Medford, OR 97501
(503) 772-2782

