

13080

Survey for

Mary H. Weidman
167 Napa Street
Eagle Point, Oregon
97524

Location

NE 1/4 of Section 3 in D.L.C.
No. 45, T.36S., R.1W., W.M. and
Lots 4, 5, 6, 7 & 8, Blk. 6 of CENTRAL
ADDITION to the City of
Eagle Point, Jackson County,
Oregon

Survey by:


Kaiser Surveying
19440 Highway 62
Eagle Point, Oregon
97524

Date

July 15, 1992

Legend

- Found monument as indicated
- Set 5/8" x 24" Rebar with plastic cap marked "KAISER RLS 803"

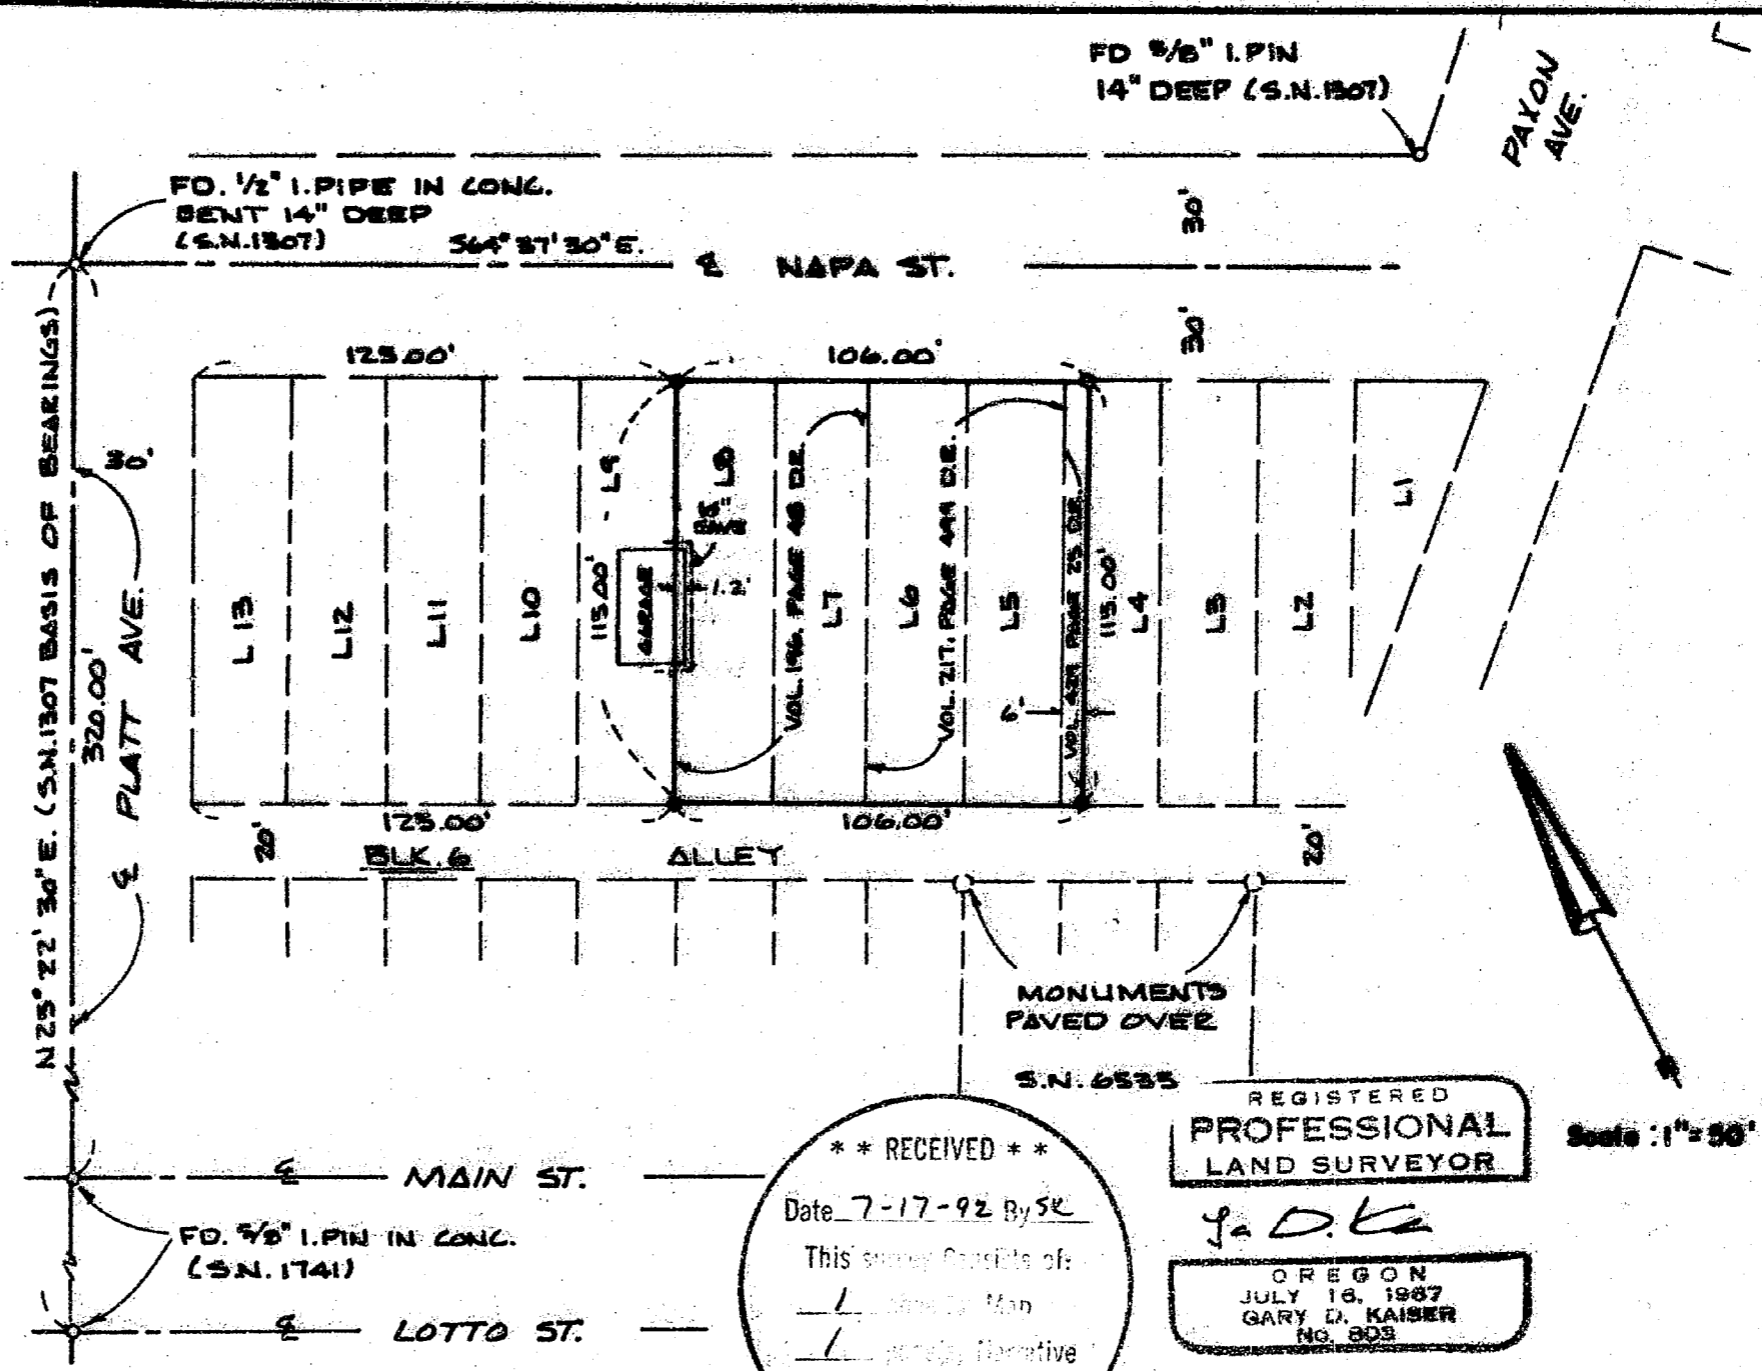

**** RECEIVED ****
 Date 7-17-92 By SK
 This survey consists of:
1 map
1 narrative
 JACKSON COUNTY
 SURVEYOR

S.N. 6535
 REGISTERED
**PROFESSIONAL
 LAND SURVEYOR**
G. D. Kaiser
 OREGON
 JULY 18, 1987
 GARY D. KAISER
 NO. 803

Scale: 1" = 50'

361W 348-200

13080

GARY D. KAISER
R.P.L.S. ORE. 803
C.W.R.E. ORE. 73

KAISER SURVEYING
19440 HIGHWAY 62
EAGLE POINT, OREGON 97524

PHONE
SHADY COVE (503) 878-3995
MEDFORD PHONE/FAX (503) 779-8040

SURVEY NO. 13080

SURVEY NARRATIVE TO COMPLY WITH O.R.S. 209.250

SURVEY FOR: MARY H. WEIDMAN
167 NAPA STREET
EAGLE POINT, OR 97524

SURVEY BY: KAISER SURVEYING
19440 HWY. 62
EAGLE POINT, OR 97524


LOCATION: NE ¼ of Section 3 in D.L.C. No. 45,
T. 36 S., R. 1 W., W.M. and Lots 4,
5, 6, 7 and 8, Blk. 6 of CENTRAL
ADDITION to the City of Eagle Point,
Jackson County, Oregon

BASIS OF BEARINGS: Centerline of Platt Ave. per Filed
Survey No. 1307

DATE: July 15, 1992

PURPOSE: To monument that tract described in
Vol. 196, Page 48 D.R., Vol 217,
Page 499 D.R. and Vol. 429, Page 25
D.R..

PROCEDURE: Utilizing street centerline and
right-of-way monuments set on Filed Survey Nos. 1307 and
1741 for control, the desired tract boundaries were
monumented as shown on the annexed map.

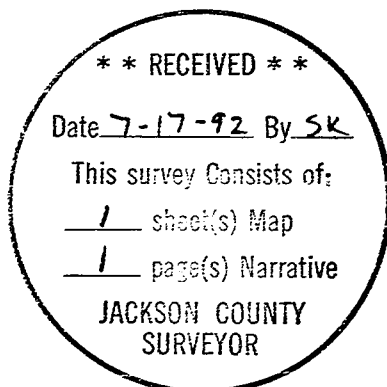

G. D. Kaiser

