
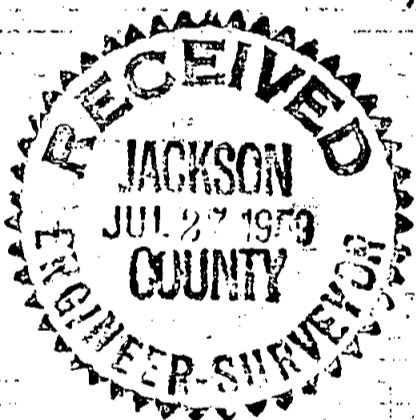


Survey For
HELEN DUGAN et al
Located in Sec. 4, T.36S.R.1W.
By: Mark E. Boyden
July 1959.

N.W. cor. D.L.C. No. 48
Fd. 1-1/2" i. pipe

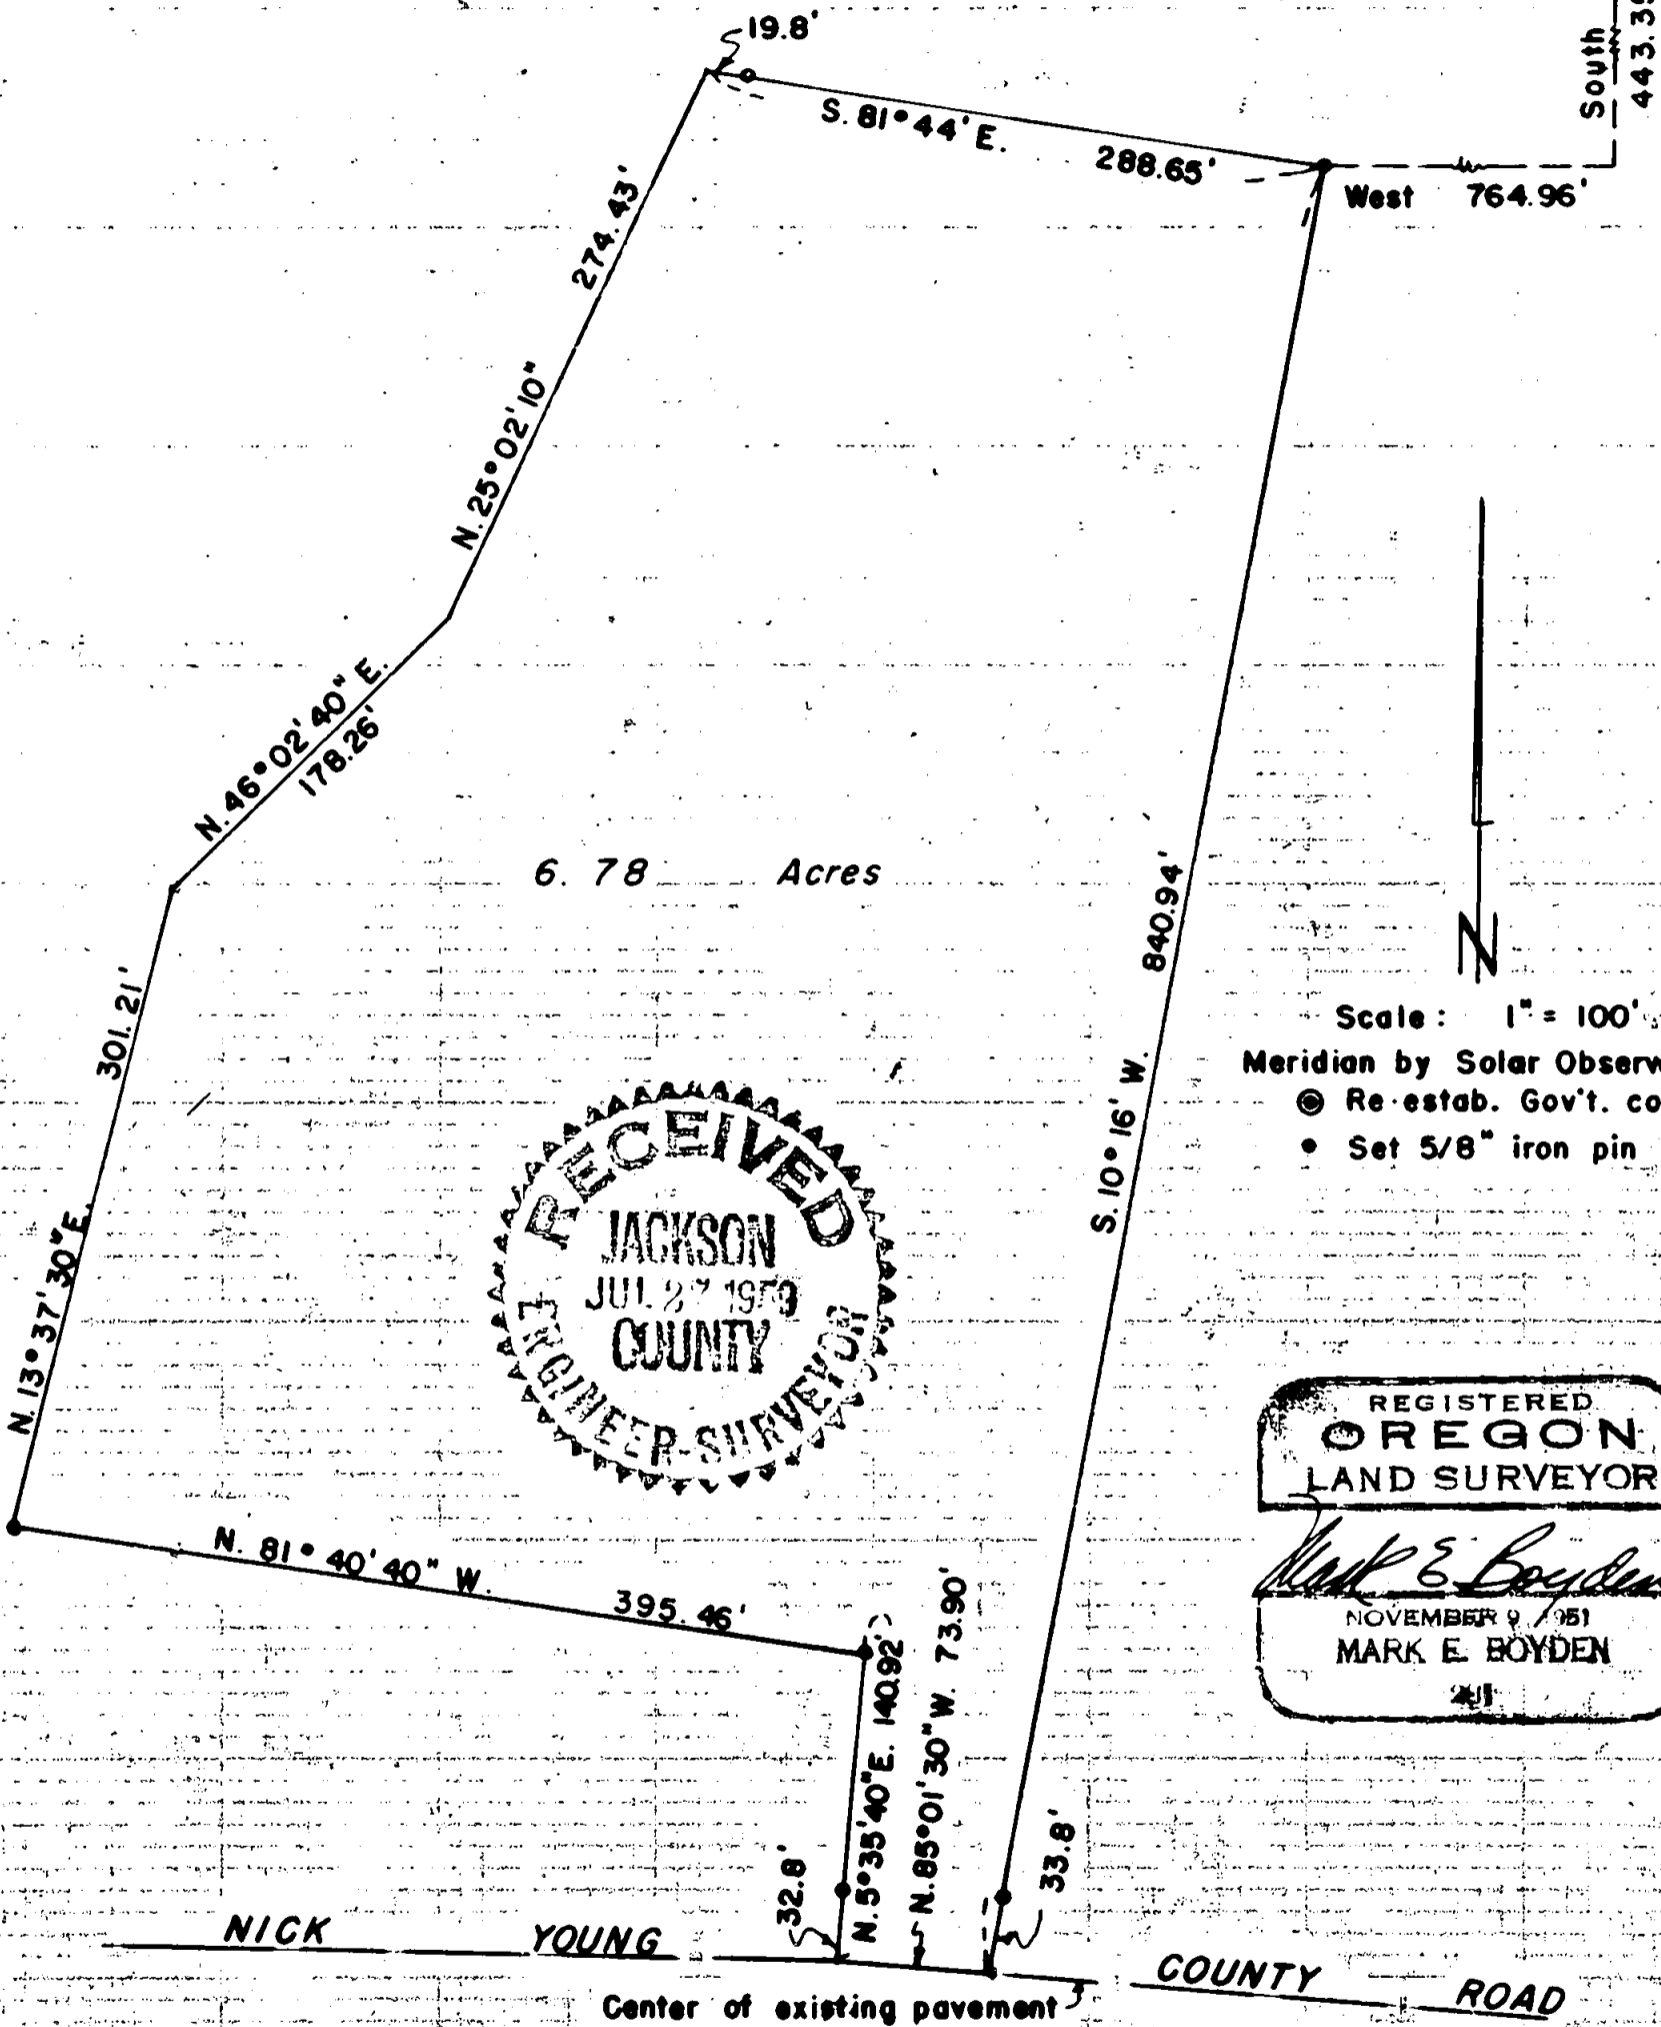

Scale: 1" = 100'

Meridian by Solar Observation

- Re-estab. Gov't. cor.
- Set 5/8" iron pin

REGISTERED
OREGON
LAND SURVEYOR

Mark E. Boyden

NOVEMBER 9 1951
MARK E. BOYDEN

Survey Narrative to Comply With Paragraph 209.250
Oregon Revised Statutes

FOR: Helen Dugan Et Al

PURPOSE: To monument and describe a parcel out of the over-all Dugan property described in Jackson County Deed Record, Volume 405, Page 469, as directed, being located in Section 4, Township 36 South, Range 1 West.

PROCEDURE:

Found the Northwest corner of DLC #48, being a 1½" galvanized iron pipe and witness trees as reported in the official county re-establishment of 1939. Traversed from said DLC corner to the Northeast corner of the tract being surveyed and then around same as shown on the attached map.

In that the exact location of the Nick Young county road is uncertain as of this date, the Southerly corners of the surveyed tract were located in the center of the existing pavement and the description made "Subject To" the rights of the public in that portion lying within the right-of-way of the Nick Young county road.

July 1959

