


# Property Line Adjustment

Approved by the Jackson County Department  
of Planning and Development (No. 92-32 LLA)  
by Carol Parker Date 8-21-92

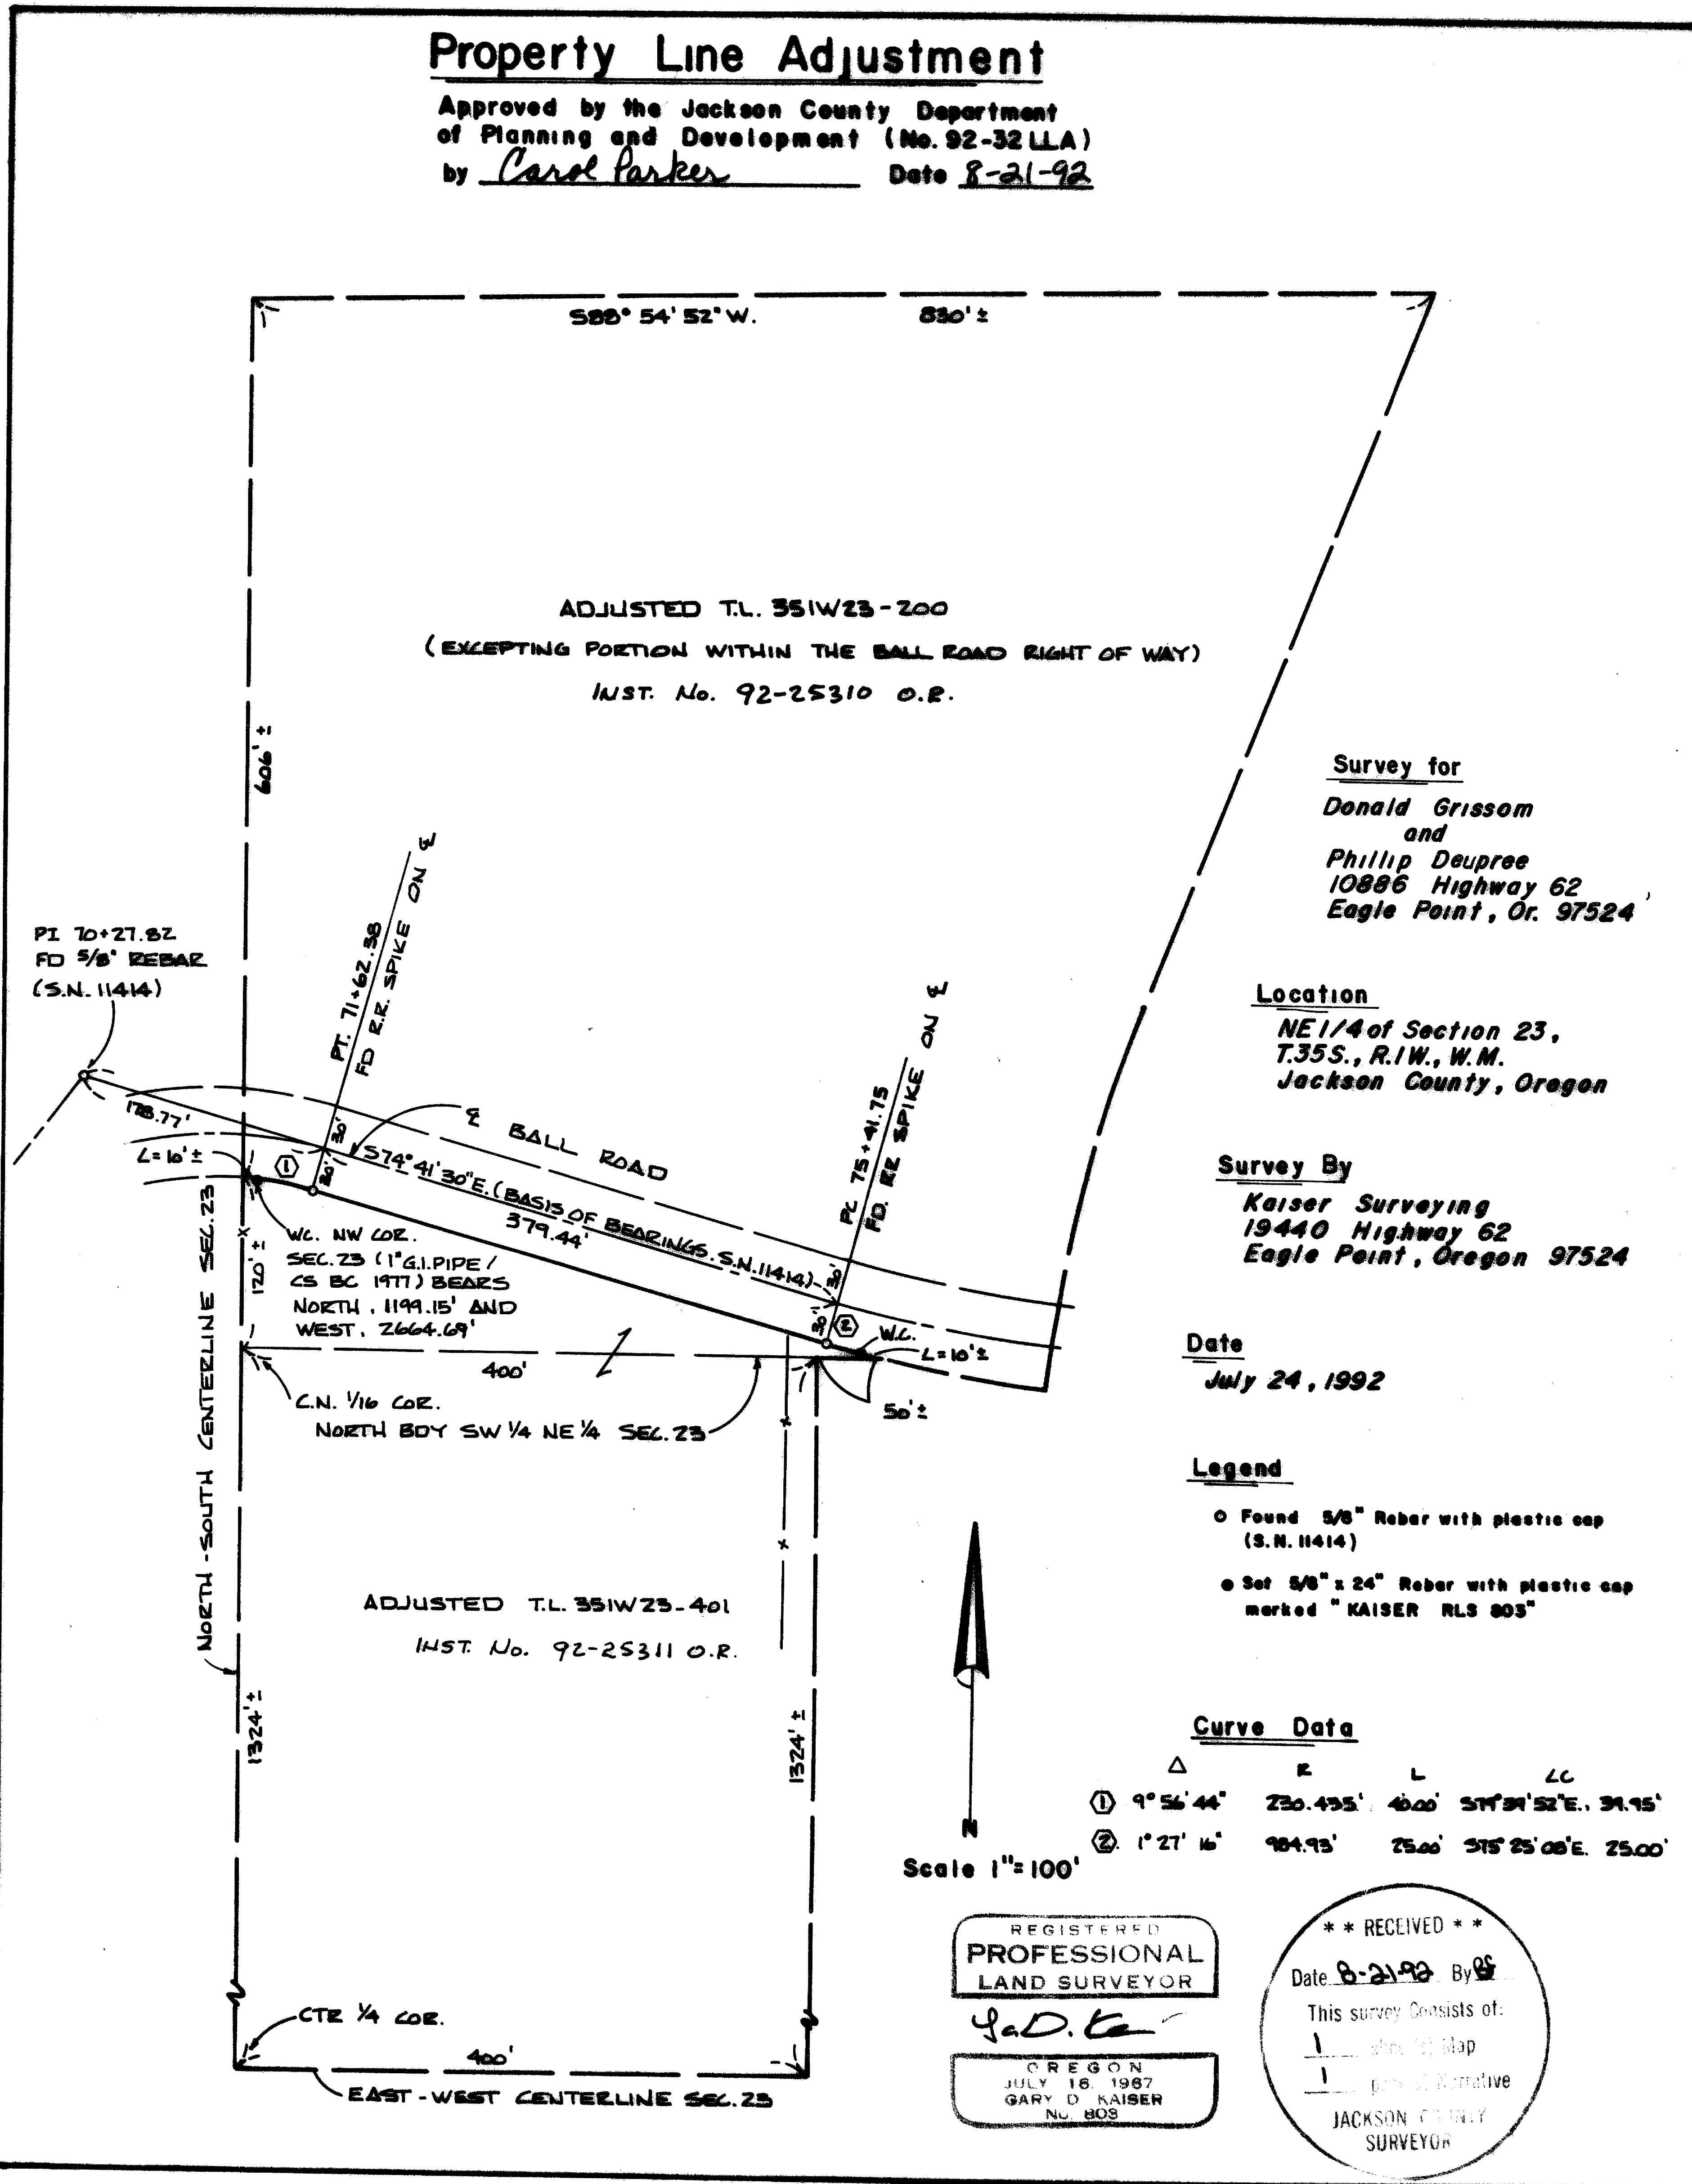

GARY D. KAISER  
R.P.L.S. ORE. 803  
C.W.R.E. ORE. 73

**KAISER SURVEYING**  
19440 HIGHWAY 62  
EAGLE POINT, OREGON 97524

**PHONE**  
SHADY COVE (503) 878-3995  
MEDFORD PHONE/FAX (503) 779-8040

SURVEY NO. 13122

SURVEY NARRATIVE TO COMPLY WITH O.R.S. 209.250

SURVEY FOR: DONALD GRISSOM  
AND  
PHILLIP DEUPREE  
10886 HWY. 62  
EAGLE POINT, OR 97524

SURVEY BY: KAISER SURVEYING  
19440 HWY. 62  
EAGLE POINT, OR 97524



LOCATION: NE ¼ of Section 23, T. 35 S.,  
R. 1 W., W.M., Jackson County,  
Oregon

BASIS OF BEARINGS: Filed Survey No. 11414 (Centerline  
of Ball Road between Sta. Pt.  
71 + 62.38 and Sta. PC. 75 + 41.75)

DATE: July 24, 1992

PURPOSE: To monument the new boundary (set  
witness corners for) between Tax  
Lot Nos. 200 & 401 - 35 1W 23 as  
approved for property line  
adjustment by Jackson County (see  
File No. 92-32-LLA).

PROCEDURE: Computed a subdivision of Section 23  
from surveys of record and also computed intersection points  
of the North-South centerline of said Section 23 and the  
North boundary of the SW ¼ of the NE ¼ of said 23 with the  
Southerly right-of-way line of Ball Road. With this  
information in hand I proceeded to the field and set the  
witness corners as shown on the annexed map referencing the  
Westerly and Easterly ends of the new boundary between Tax  
Lots 200 and 401. A tie was also made to the NW corner of  
said Section 23.

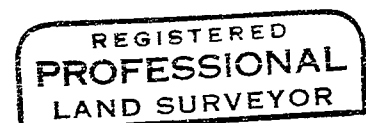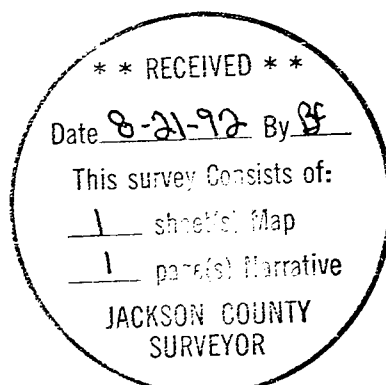

*J. D. Ka*

