
MAP OF SURVEY

LOCATED in D.L.C. No. 40 & the NW 1/4 of Sec. 9,

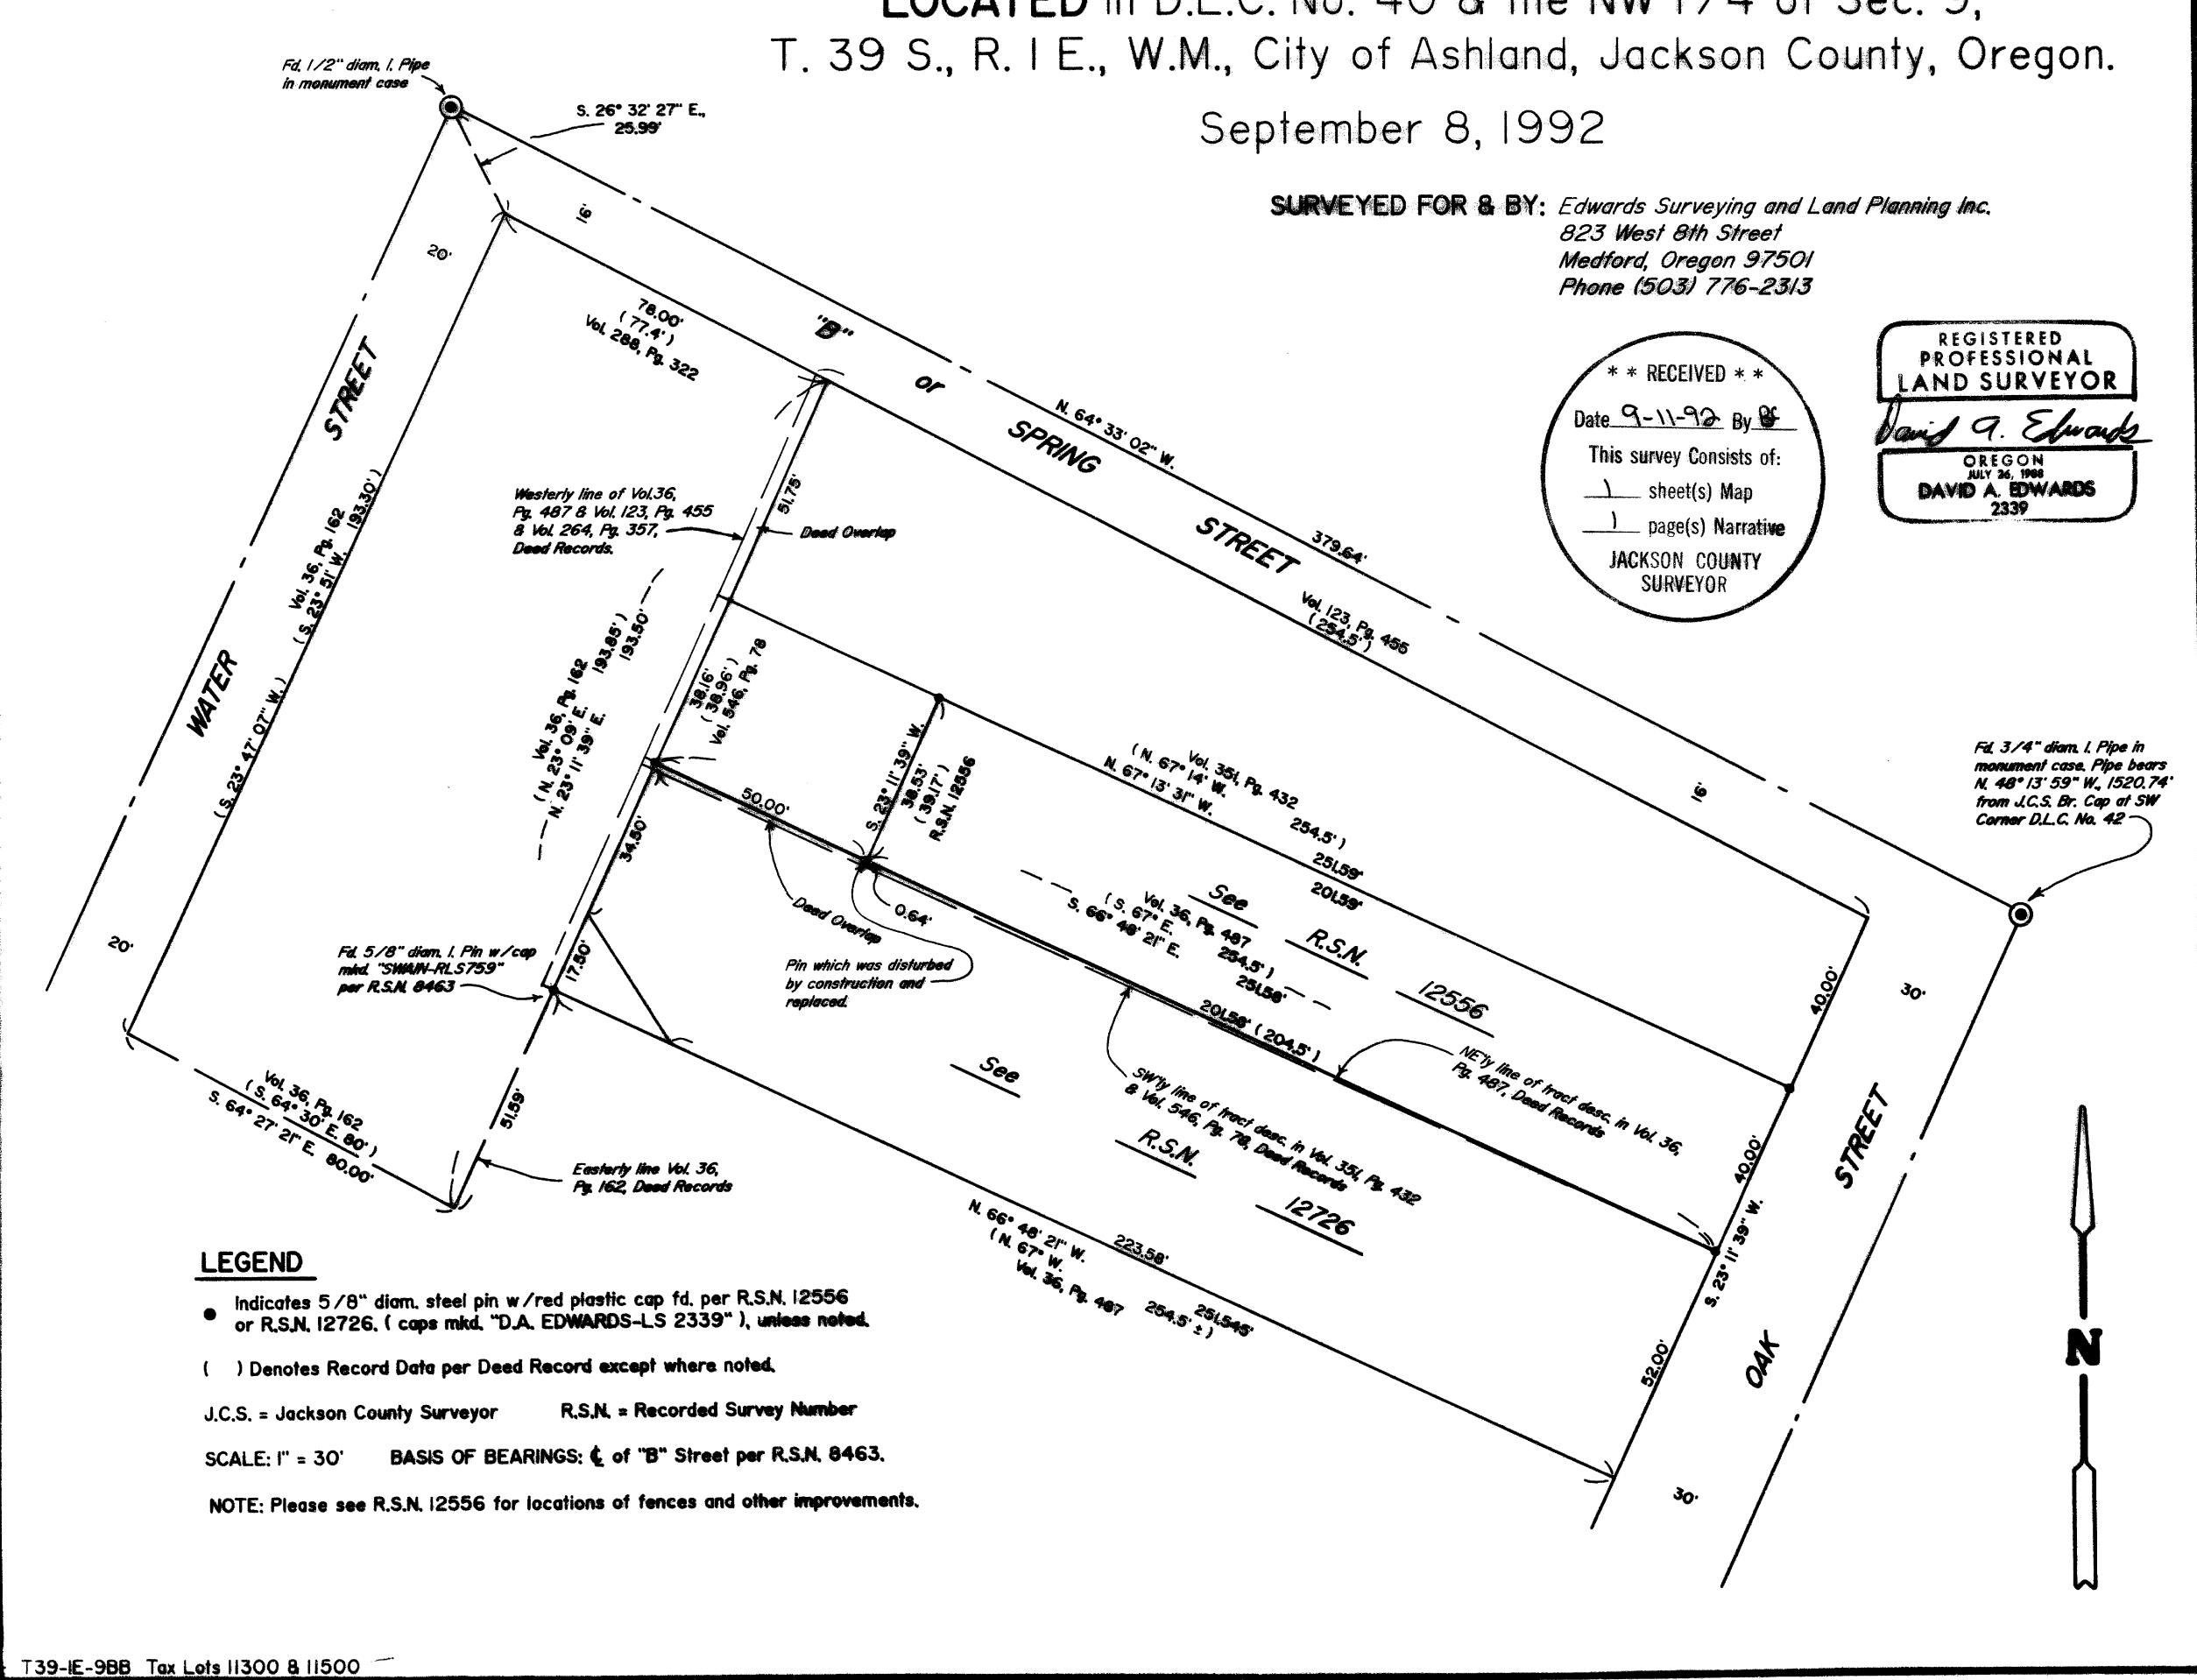

Edwards Surveying & Land Planning Inc.

DARREL W. EDWARDS OREGON REG. 741 Arizona reg. 9746



DAVID A. EDWARDS OREGON REG. 2339

REGISTERED LAND SURVEYORS 823 WEST 8TH ST. MEDFORD, OREGON 97501 (503) 776-2313 • (503) 471-7059

13146

SURVEY NUMBER

SURVEY NARRATIVE TO COMPLY WITH CHAPTER 209, PARAGRAPH 250, OREGON REVISED STATUTES

SURVEY FOR:

Edwards Surveying & Land Planning, Inc.

823 West 8th Street Medford, Oregon 97501

LOCATION:

In D.L.C. No. 40 and the NW 1/4 of Section 9,

T. 39 S., R. 1 E., W.M., City of Ashland,

Jackson County, Oregon.

PURPOSE:

To more clearly identify a deed overlap referred to in R.S.N. 12726 and to show an amended distance along the Westerly line of tax lot 11300 from that which was shown on my

survey R.S.N. 12556.

PROCEDURE:

Both of the above noted surveys were performed under my direction in 1991. As spelled out in the narrative for the later survey, additional evidence was discovered after the recording of R.S.N. 12556, which I deemed important enough to relocate one of my earlier pins. The

accompanying map clarifies that dimension along the Westerly line of tax lot 11300 (R.S.N. 12556) and shows the deed overlap in a graphic fashion. The SE'ly corner of tax lot 11300 was not affected by the older deed which is Vol.

36, Pg. 487, Deed Records, being the additional evidence named above. The pin which was relocated per R.S.N. 12726 was disturbed during construction of a retaining wall on tax lot

11500 and was subsequently replaced at the position shown on that survey and as shown on

the accompanying map by this office.

BASIS OF BEARINGS:

Center line of "B" St. per R.S.N. 8463

EQUIPMENT:

Nikon NTD-4 Semi-automatic theodolite/E.D.M.

DATE

COMPLETED:

September 8, 1992.

REGISTERED * * RECEIVED * * PROFESSIONAL LAND SURVEYOR Date 9-11-92 By B This survey Consists of: Edwards 19. _ sheet(s) Map OREGON JULY 26, 1988 DAVID A. EDWARDS JACKSON COUNTY **SURVEYOR**