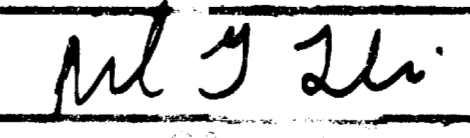


LEGEND

- FD. JACKSON COUNTY BRASS CAP, PER RE-ESTABLISHMENT BOOK, PAGE 71
- ⊗ FD. JACKSON COUNTY BRASS CAP, PER RE-ESTABLISHMENT BOOK, PAGE 23
- FD. JACKSON COUNTY BRASS CAP, PER RE-ESTABLISHMENT BOOK, PAGE 26
- FD. JACKSON COUNTY BRASS CAP, PER RE-ESTABLISHMENT BOOK, PAGE 27
- FD. JACKSON COUNTY BRASS CAP, PER RE-ESTABLISHMENT BOOK, PAGE 53
- SET 5/8" x 30" REBAR WITH YELLOW PLASTIC CAP MARKED "TEMPLIN LS2359"
- ⊙ FD. 1" X 30" GALV. IRON PIPE WITH YELLOW PLASTIC CAP IN TOP MARKED "TEMPLIN LS 2359" PER R.S. 12933
- FD. 5/8" REBAR WITH YELLOW PLASTIC CAP MARKED "TEMPLIN LS 2359" PER R.S 12933

*** RECALC ***
 Date 10-6-92 SC
 The
 /

BASIS OF BEARING BASED ON SOLAR OBSERVATION

REGISTERED PROFESSIONAL LAND SURVEYOR  RICHARD TEMPLIN	RICHARD TEMPLIN LAND SURVEYING 2042 SANDRA PL 776-0991 & 474-7720 MEDFORD, OREGON
	MAP OF SURVEY LOCATED IN SECTION 36, T.35S., R.4W., W.M. JACKSON COUNTY, OREGON SURVEYED FOR: MEDFORD CORPORATION P.O. BOX 550 MEDFORD, OREGON DATE: MARCH 23, 1992

RICHARD G. TEMPLIN
PROFESSIONAL LAND SURVEYOR
2042 Sandra Pl.
Medford, Oregon 97504
(503) 776-0991 • 474-7720

NARRATIVE

Survey No. 13176

SURVEY FOR: Medco Corporation
P.O. Box 550
Medford, Oregon 97501

LOCATION: Section 36, Township 35 South, Range 4 West, of
the Willamette Meridian, Jackson County, Oregon.

PURPOSE: To set the Center South 1/16th corner of Section
36.

DATE: March 23, 1992

BASIS OF BEARING: Bearings based upon R.S. number 12933.

PROCEDURE From previous set control points, computed the
position of the CS 1/16th corner and set:

A 5/8" x 30" rebar with yellow plastic cap marked
"TEMPLIN L.S.2359", from which I scribed the
following bearing trees:

A Douglas Fir, 8" diameter bears N 30° E, 10.2
feet, scribed "CS1/16S36" "BT".

A Black Oak, 6" diameter bears N 88° W, 15.9 feet
scribed "CS1/16S36" "BT".

