


MAP OF SURVEY

LOCATED in the NW 1/4 of Section 4,
T. 36 S., R. 1 W., W.M., Jackson County, Oregon.

October 2, 1992

SURVEYED FOR: *Betty Murray Taylor*
P.O. Box 864
Eagle Point, Oregon 97524

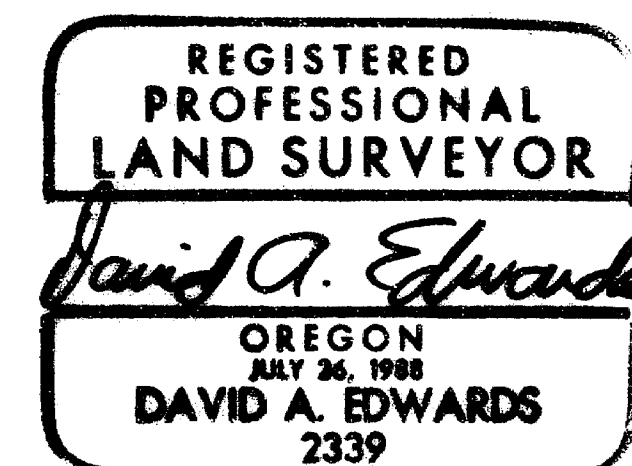

SURVEYED BY: *Edwards Surveying and Land Planning, Inc.*
823 West 8th Street
Medford, Oregon 97501
Phone: (503) 776-2313

LEGEND

- ▲ Indicates 3/4" diam. I. Pipe fd. per R.S.N. 3080.
- Indicates 5/8" diam. I. Pin fd. per R.S.N. 7065.
- Indicates 5/8" x 24" steel pin w/red plastic cap mkd. "D.A. EDWARDS-LS 2339" set.

() Denotes Record Data per R.S.N.

[] Denotes Deed Record Data


--- fence line

R.S.N. = Recorded Survey Number

J.C.S. = Jackson County Surveyor

SCALE: 1" = 200'

BASIS OF BEARINGS = North line of NW 1/4, Section 4, per R.S.N. 7065.

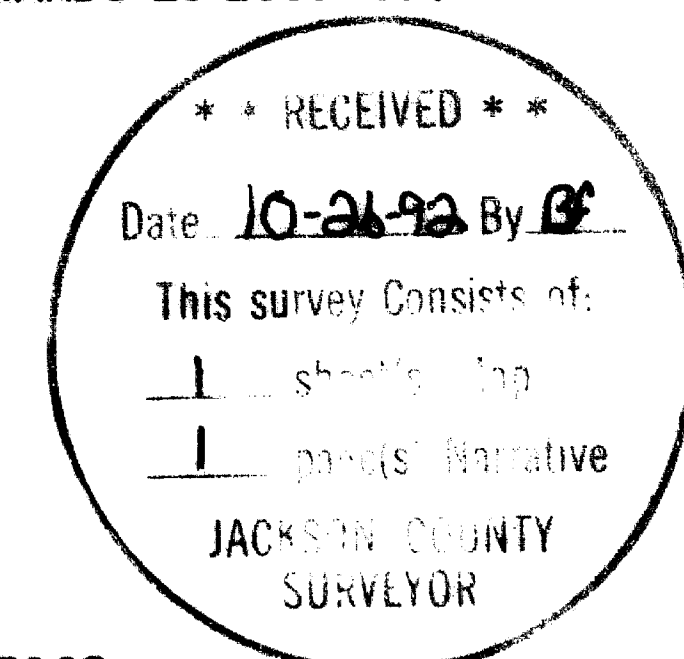

Edwards Surveying & Land Planning Inc.

DARREL W. EDWARDS
OREGON REG. 741
ARIZONA REG. 9746



REGISTERED LAND SURVEYORS
823 WEST 8TH ST.
MEDFORD, OREGON 97501
(503) 776-2313 • (503) 471-7059

DAVID A. EDWARDS
OREGON REG. 2339

SURVEY NUMBER 13199

SURVEY NARRATIVE TO COMPLY WITH CHAPTER 209, PARAGRAPH 250,
OREGON REVISED STATUTES

SURVEY FOR: Betty Murray Taylor
P.O. Box 864
Eagle Point, Oregon 97524

LOCATION: In the NW 1/4 of Section 4, T. 36 S.,
R. 1 W., W.M. in Jackson County, Oregon.

PURPOSE: To locate and monument the North and East
boundary of tract described in Doc. No. 92-
17779, Official Records, as shown on the
accompanying map.

PROCEDURE: Utilizing for control the found monuments of
record per Recorded Surveys Numbered 3080 and
7065, the Section and 1/4 corners and data
found in the above noted deed, computed the
tract boundaries. Slight variations from the
record bearings and distances shown on R.S.N.
7065 were discovered. The found monuments were
held to as shown. Monuments set on this survey
consist of 5/8" x 24" steel pins w/ red plastic
caps mkd. "D.A. EDWARDS-LS 2339".

BASIS OF BEARINGS: North line of NW 1/4 Sec. 4 per R.S.N. 7065.

EQUIPMENT: Nikon DTM-A5 Electronic Total Station.

DATE COMPLETED: October 2, 1992.

