


Survey For
 KOGAP MANUFACTURING CO.
 Located in D.L.C. 45,
 Sec. 31, T.37 S.R.1W., W.M.
 By: Mark E. Boyden
 Feb. 1955 - June 1959.



SCALE: 1" = 200'

- Iron pin
- Iron pipe unless otherwise indicated.

REGISTERED
OREGON
 LAND SURVEYOR
Mark E. Boyden
 NOVEMBER 11, 1951
 MARK E. BOYDEN
 281

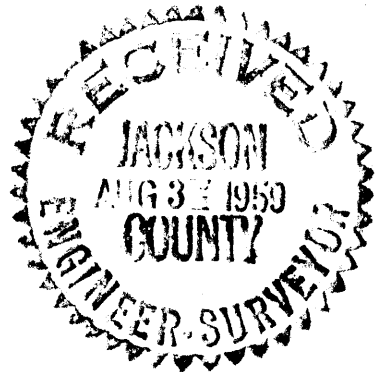

Survey Narrative to Comply With Paragraph 209.250

Oregon Revised Statutes

FOR: KOGAP Manufacturing Co.

PURPOSE: To monument property recently purchased by KOGAP and described in Jackson County Deed Records Volume 470, Pages 191, 193, 195, 197 and Volume 405, Page 453. Also, the Coffeen property as described in Volume 169, Page 66 of said Deed Records.

PROCEDURE: Found monuments as shown, having been previously set or used by this office on Recorded Survey Nos. 640, 793 and 1056.

Monumented the additional parcels as shown.

July 1959



Mark E. Boyden
NOVEMBER 9, 1959
MARK E. BOYDEN
281

