


MAP OF SURVEY  
 FOR  
 L. A. BRATCHER, ASHLAND, ORE.  
 IN SECTION 18, T. 39S. R. 1E.  
 W.M. JACKSON CO. OREGON.  
 Date: 6-20-58 - SCALE: 1"=600'  
 STAFF COMPASS & CHAIN  
 SURVEY.

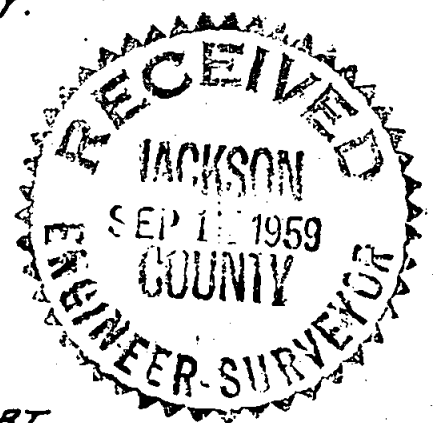

REGISTERED  
 OREGON  
 LAND SURVEYOR

*L. E. Ager*

MARCH 10, 1944  
 L. E. AGER  
 21

Survey narrative to comply with Section 87-330 Oregon State Law of 1947

For: L. A. Bratcher, Ashland, Oregon

Purpose: To divide the East Half of Section 18, T.39 S., R. 1 E., W.M., Oregon, North-South.

Proceedure: Retraced the east boundary of Section 18, running north from the southeast corner which was in place and at a point  $\frac{1}{2}$  mile north I found the stump of the witness tree for the  $\frac{1}{4}$  corner in Section 17, both upper and lower blazes plainly visible and from this tree I set a  $\frac{1}{2}$  inch pipe for the  $\frac{1}{4}$  corner according to the bearing & distance set forth in original field notes. To perpetuate this I scribed new witness trees as follows:

A Laurel 16 inches in dia. bears S.71°00'W. 15.4 feet.  
A Laurel 28 inches in dia. bears S.15°00'E. 30.7 feet.  
The above trees scribed  $\frac{1}{4}$  L.S. B.T.

From this reestablished  $\frac{1}{4}$  corner I measured West 1324 feet and set an iron bar from which I blazed a direct line to the 1/16 corner on the north line of the east half and also a direct line to the 1/16 corner on the south line of the east half of Section 18. The 1/16 corners on the north and south line of the east half were previously set by the Jackson County Surveyor.

The east line of Section 18 dog legs at the  $\frac{1}{4}$  corner and evidently the original survey did not carry through from Section corner to Section corner. The old original line blazes were in evidence from the south east corner to the east  $\frac{1}{4}$  corner and the old line topog. checked good but going north to the northeast corner there were no evidence of old blazes and the line topog. was out. All evidence indicates the east  $\frac{1}{4}$  corner was stubbed in from the southeast corner.

REGISTERED  
OREGON  
LAND SURVEYOR

*L. E. Ager*

MARCH 10, 1944  
L. E. AGER  
21

