
MAP OF SURVEY For THOMAS JOHNSTON

Located in:

Lot 5, Block 4 of WEST WALNUT PARK ADDITION to the City of Medford in S.W. 1/4 of Section 25, T.37S., R.2W., W.M., Jackson County, Oregon

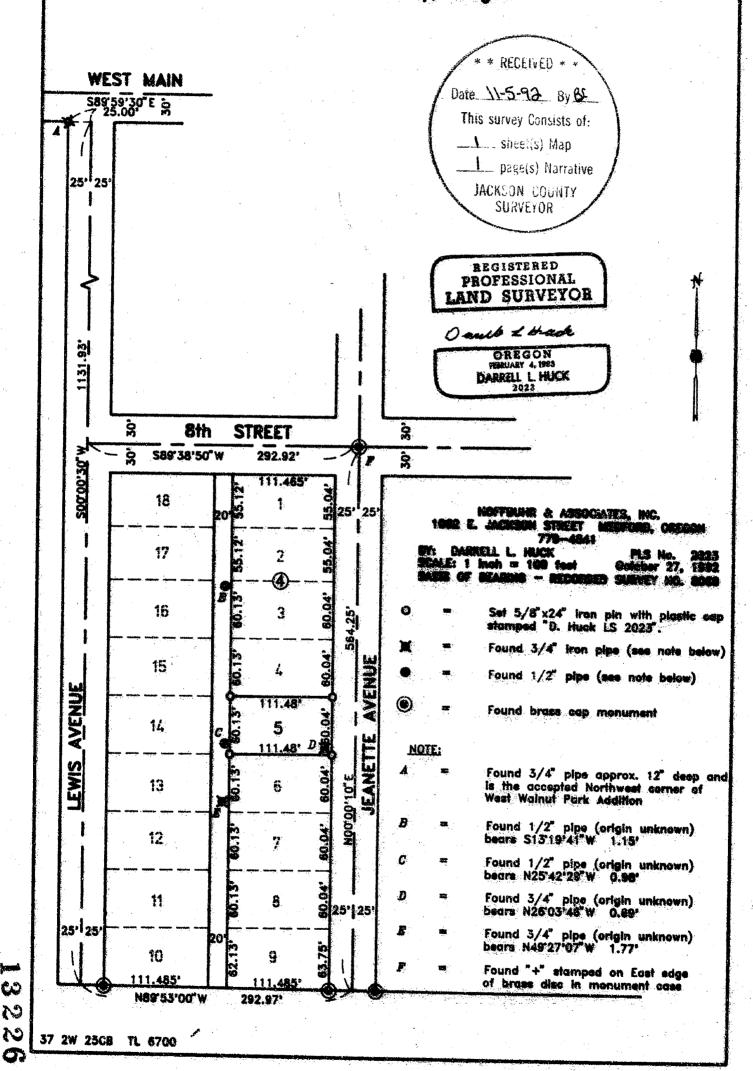

SURVEY NO.

SURVEY NARRATIVE TO COMPLY WITH PARAGRAPH 209.250 OREGON REVISED STATUTES

Survey for:

Thomas Johnston

3932 Avenue A

White City, Oregon 97503

Location:

Lot 5, Block 4 of WEST WALNUT PARK ADDITION to the City of Medford, in the Southwest onequarter (1/4) of Section 25, Township 37 South, Range 2 West, Willamette Meridian in

Jackson County, Oregon

Purpose:

To survey and monument Lot 5 of Block 4 in WEST WALNUT PARK ADDITION to the City of Medford

theodolite and one-second electronic distance measuring equipment, a control traverse was run tying found monuments as shown on the attached map.

West Walnut Park Addition was surveyed by Olen Arnspiger in February of 1910, the plat giving no indication of any monuments being set. A 3/4 inch iron pipe found at the Southwest intersection of Lewis Avenue and West Main Street has been used and accounted as the Northwest corner of West Walnut Bark Addition and accepted as the Northwest corner of West Walnut Park Addition and was accepted as such for this survey. Brass disc monuments in concrete were found at the Southwest and Southeast corners of In concrete were round at the Southwest and Southeast corners of Block 4 of Walnut Park Addition and as noted in the Survey Narrative of Recorded Survey No. 8090, were apparently established from traverse data found in City Field Book No. 256, Basis of Bearing;

Recorded Survey No. 8069

Date:

October 27, 1992

* * RECEIVED * * Date 11-5-92 By This survey Consists of: sheel(s) Map ा page(s) Narrative JACKSON COUNTY SURVEYOR

REGISTERED **PRO**FESSIONAL LAND SURVEYOR

DanW & Huck

OREGON DARRELL L. HUCK

Darrell L. Huck Hoffbuhr & Associates, Inc. 1062 East Jackson Street Medford, Oregon 97504