

SURVEY NO. 13233

SURVEY NARRATIVE TO COMPLY WITH PARAGRAPH 209.250
OREGON REVISED STATUTES

Survey for: Gregg Adams
P.O. Box 1084
Medford, Oregon 97501


Location: Lots 4, 5, 6 and 8 of ELEVEN-EIGHTY ORCHARD TRACTS in the Southeast one-quarter (1/4) of Section 3, Township 37 South, Range 1 West, Willamette Meridian, Jackson County, Oregon

Purpose: To survey and monument Lots 4, 5, 6 and 8 of ELEVEN-EIGHTY ORCHARD TRACTS per client's request.

Procedure: I utilized found monumentation from Survey Number 2677 to establish proportion distances for Lots 5, 6 and 8. The one inch capped iron pipe to the North, thought to be an original monument, was held for Easting only as Survey Number 8202 establishes the North line on the East-West centerline of Section 3. Monuments were set as shown on the accompanying map.

Basis of Bearing: Survey Number 2677

Date: November 5, 1992

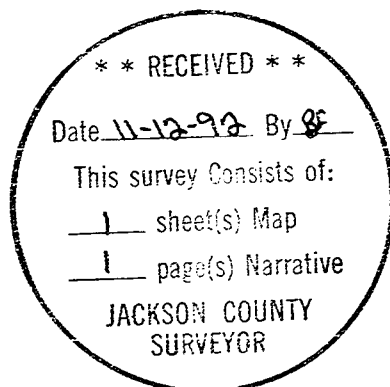

David M. Minneci
Hoffbuhr & Associates, Inc.
1062 East Jackson Street
Medford, Oregon 97504