


1325

Survey for
H.M. CHRISTOFFERSEN
R. C. LINDSAY
J.R. WINN
Located in D.L.C. 79
Sec. 35, T.37S.R.2W, W.M.
By: Mark E. Boyden
Sept. 1959

REGISTERED
OREGON
LAND SURVEYOR

Mark E. Boyden
NOVEMBER 9, 1951
MARK E. BOYDEN
281

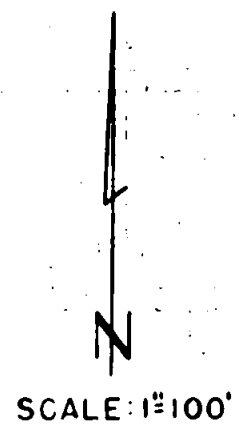

- Re-established Govt. cor.
- Found 5/8" iron pin
- Set 5/8" iron pin

Fd. stone with 'x'
N.W. cor. D.L.C. 80

Fd. stone with 'x'
S.W. cor. D.L.C. 77

Fd. stone with 'x'
N.E. cor. D.L.C. 79

STEWART AVE.

1486.26'

25' 25"

ROAD
1796.26'

THOMAS

306.80'

N 0° 03' 30" W

25' 25"

Fd. 5/8" iron pin on
D.L.C. line
(see recorded survey no.)
1050

S 89° 58' 20" W 591.33'


WILLOWAY

N 89° 58' 20" E 591.35'

North
306.80'

456.67'

N 89° 58' 20" E

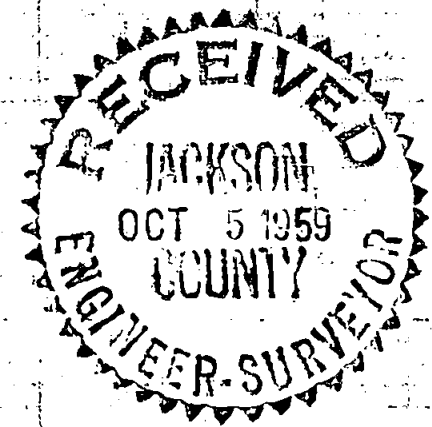

Survey Narrative to Comply With Paragraph 209.250

Oregon Revised Statutes

FOR: H. M. Christoffersen
R. C. Lindsay
J. R. Winn

PURPOSE: To monument and describe the Willoway right-of-way according to the plan of CHERRY PARK (an unrecorded Subdivision) and to extend said right-of-way Easterly to Thomas Road, so that the legal owners of this roadway strip can quit-claim their interest to Jackson County for roadway purposes, being located in D.L.C. No. 79, Section 35, Township 37 South, Range 2 West.

PROCEDURE:

Traversed from the Northeast corner of D.L.C. No. 79 to the Northwest corner of D.L.C. No. 80, tying in the Thomas Road control and the North line of D.L.C. No. 80 as established previously on Recorded Survey No. 1050. From this information, established the Willoway Road centerline parallel to and 316.80 feet Northerly at right angles from the North line of said D.L.C. No. 80. The West end of the Willoway Road was established on a deed record Westing from the Northeast corner of D.L.C. No. 79 (See Jackson County Deed Records Volume 259, Page 256 and Volume 356, Page 270).

Monumented the roadway with 5/8" x 30" iron pins as shown.

September 1959

