

- LEGEND**
- FD. BRASS CAP IN CONCRETE PER JACKSON COUNTY REESTABLISHMENT BOOK, PG. 101
 - FD. BRASS CAP PER JACKSON COUNTY REESTABLISHMENT BOOK, PG. 57
 - FD. BRASS CAP MONUMENT PER RS 9703
 - FD. 5/8" IRON ROD WITH YELLOW PLASTIC CAP MARKED " D. McMAHAN LS1913 "
 - SET 5/8" X 30" REBAR WITH YELLOW PLASTIC CAP MARKED " TEMPLIN LS2359 "
 - △ CALCULATED POSITION
 - () RECORD BEARING/DISTANCE PER RS 9703
 - INDICATES LINES MARKED FOR FENCING

BEARINGS BASED UPON RS 9703
 ** NARRATIVE IS SEPARATE DOCUMENT **

RECEIVED
 This survey consists of:
 1 sheet(s) Map
 2 page(s) Narrative
 JACKSON COUNTY SURVEYOR

LANDS SURVEYOR
 RICHARD G. TEMPLIN
 2359

RICHARD TEMPLIN LAND SURVEYING
 2042 SANDRA PL 776-0991 & 474-7720 MEDFORD, OREGON
MAP OF SURVEY
 LOCATED IN
 E1/2 OF SECTION 34, T.36S., R.1W., W.M.
 JACKSON COUNTY, OREGON
 SURVEYED FOR: MR. H. D. LOONEY 2221 CRESTON CT. MEDFORD, OREGON 97504
 DATE: NOV. 5, 1992


RICHARD G. TEMPLIN
PROFESSIONAL LAND SURVEYOR
2042 Sandra Pl.
Medford, Oregon 97504
(503) 776-0991 • 474-7720

13263

I then ran N 00°02'40" East, along true line from the SE 1/16 corner to the CE 1/16, setting reference corners on each side of the irrigation canal, as shown on accompanying map.
I then ran N 00°18'39" West, from the CE 1/16 corner to the E 1/16 corner on the North line of Section 34, at said E 1/16 corner I set:

A 5/8" rebar with a yellow plastic cap marked "TEMPLIN LS 2359 ", from which I scribe the following bearing trees:
A White Oak, 14" diameter scribed "E1/16S34" "BT" bears S 37° E, 32.7 feet.
A Black Oak, 12" diameter scribed "E1/16S27" "BT" bears N 9° W, 16.1 feet.
A 1" diameter iron pipe bears S 52° E, 4.14 feet.

I set along true line, 60d spikes and Glo-Top stakes at frequent intervals for fence building purposes.

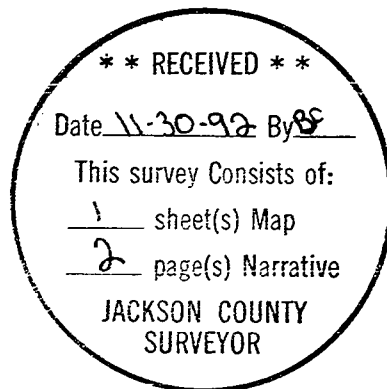

RICHARD G. TEMPLIN
PROFESSIONAL LAND SURVEYOR
2042 Sandra Pl.
Medford, Oregon 97504
(503) 776-0991 • 474-7720

NARRATIVE

Survey No. **13263**

SURVEY FOR: Mr. H.D. Looney
2221 Creston Ct.
Medford, Oregon 97504

LOCATION: E 1/2 of Section 34, Township 36 South, Range
1 West, of the Willamette Meridian, Jackson
County, Oregon.

PURPOSE: To survey and the mark the East line of the W 1/2
of the NE 1/4 and the East line of the NW 1/4 of
the SE 1/4 of said Section 34.

DATE: November 5, 1992

BASIS OF Bearings based upon R.S. 9703; the East- West
centerline of Section 34.

PROCEDURE: Tied the NE corner of Section 34, N 1/4, E 1/4,
and the C 1/4 of Section 34. Bearings and
distances recorded on R.S. 9703 checked very
close. Using computed positions of the S 1/4 and
the SE corner of Section 34, I computed the SE
1/16 corner position and set:

A 5/8" rebar with a yellow plastic cap marked
"TEMPLIN LS 2359 ", from which I scribe the
following bearing trees:
A White Oak, 6" diameter scribed "SE1/16S34" "BT"
bears S 16° E, 45.2 feet.
A forked White Oak, 12" diameter scribed
"SE1/16S34" "BT" bears N 44° E, 8.0 feet.

I then set on the C 1/4 and set the CE 1/16
corner:

A 5/8" rebar with a yellow plastic cap marked
"TEMPLIN LS 2359 ", from which I scribe the
following bearing trees:
A White Oak, 10" diameter scribed "CE1/16S34"
"BT" bears N 70° E, 90.6 feet.
A White Oak, 10" diameter scribed "CE1/16S34"
"BT" bears S 62° E, 115.5 feet.