

Legend

- Found monument as indicated
- ⊙ Found Gov't Corner monumented by the Office of the County Surveyor
- Set 5/8" x 24" Rebar with plastic cap marked "KAISER RLS 803"
- S.N. = Survey Number -- Filed Survey in the Office of the County Surveyor
- W.C. = Witness Corner
- Rec. = Record shown on the new 1993 Deeds of Record implementing the Property Line Adjustment. The descriptions for the Deeds were prepared prior to the survey.

Property Boundary Adjustment

Approved by the Jackson County Department of Planning and Development (File No. 92-102-LLA)

By: Bobbi Becker Date 3-1-93

Survey for
 Bruce Carpenter
 P.O. Box 1045
 Eagle Point, Oregon
 97524

Survey by
 Kaiser Surveying
 19440 Highway 62
 Eagle Point, Oregon
 97524

Date February 24, 1993

Location
 NW 1/4 of Section 29 and
 Section 30, T. 35S., R. 1W., W. M.,
 Jackson County, Oregon

REGISTERED
PROFESSIONAL
 LAND SURVEYOR
 G. O. K.
 OREGON
 JULY 16, 1967
 GARY D. KAISER

RECEIVED
 Date 3-1-93 By BE
 This survey consists of:
 JACKSON COUNTY
 SURVEYOR

Tax Lot Nos. 300 + 302-351W29 and 202 + 203-351W30

GARY D. KAISER
R.P.L.S. ORE. 803
C.W.R.E. ORE. 73

KAISER SURVEYING
19440 HIGHWAY 62
EAGLE POINT, OREGON 97524

PHONE
SHADY COVE (503) 878-3995
MEDFORD PHONE/FAX (503) 779-8040

SURVEY NO. 13384

SURVEY NARRATIVE TO COMPLY WITH O.R.S. 209.250

SURVEY FOR: BRUCE CARPENTER
P.O. BOX 1045
EAGLE POINT, OR 97524

SURVEY BY: KAISER SURVEYING
19440 HWY. 62
EAGLE POINT, OR 97524


LOCATION: NW ¼ of Section 29 and
Section 30, T. 35 S.,
R. 1 W., W.M., Jackson County,
Oregon

BASIS OF BEARINGS: Northwestern boundary of tract
described in Inst. No. 85-22397
O.R., course "N 35° 28' 58" E".


DATE: February 24, 1993

PURPOSE: To monument the adjusted boundaries
of Tax Lot Nos. 35 1W 29 - 300 & 302
and 35 1W 30 - 202 & 203 as approved
for adjustment by County File No.
92-102-LLA.

PROCEDURE: Utilizing found monuments shown on
the annexed map as established by the Office of the County
Surveyor and filed Survey Nos. 2776 and 10519, record
boundaries per tract described in Inst. No. 85-22397 O.R. and
Modoc Road control per map 23/4 in the Office of the County
Surveyor for control, the desired tract boundaries were
monumented as shown.

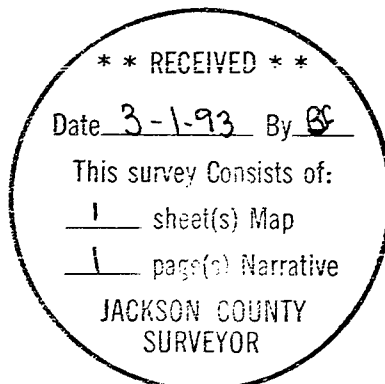

G. D. Kaiser

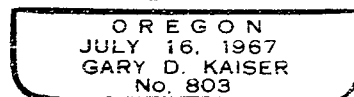

Exp. 12-31-93